


# T.38 S.R.3 W.W.M.

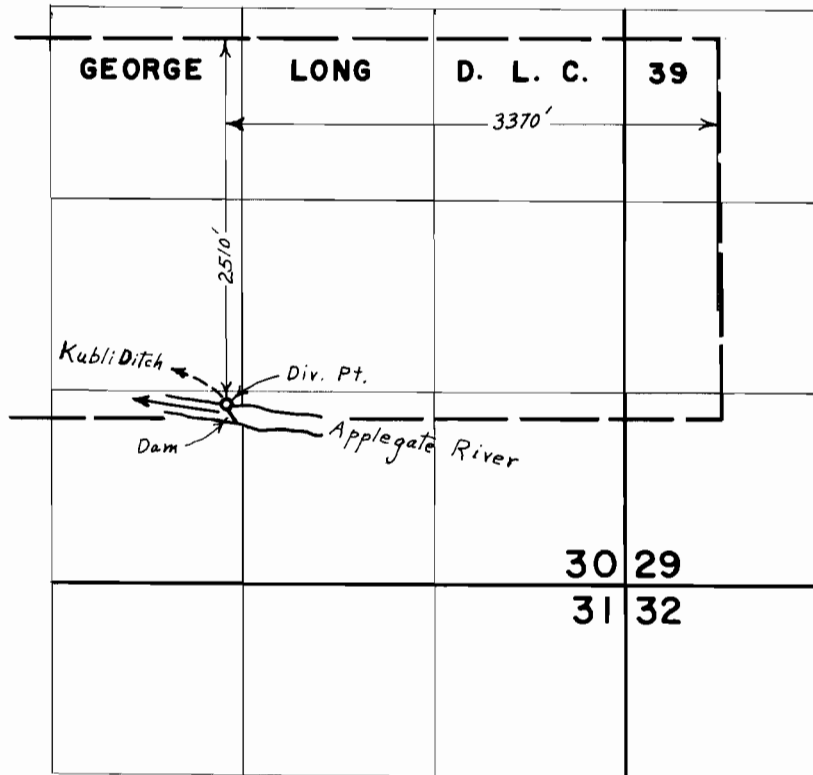

## FINAL PROOF SURVEY UNDER

Application No. \_\_\_\_\_ Transfer No. H-160  
 Permit No. \_\_\_\_\_  
 IN NAME OF  
**KUBLI DITCH**

Surveyed July 28, 1967, by L. E. Gould