


T.4S. R.39E. W.M.

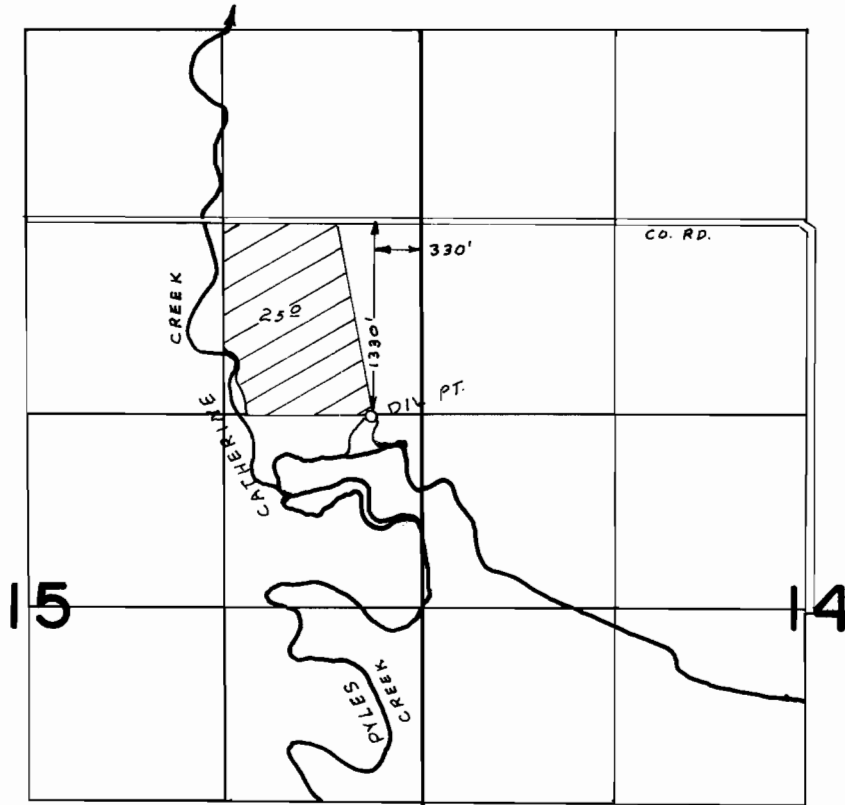

FINAL PROOF SURVEY
UNDER

Transfer No. H-167
Application No. 41573 Permit No. 30739
IN NAME OF

JOHN C. BROWN

Surveyed JUL 12 1973, by R. MUCHEN