
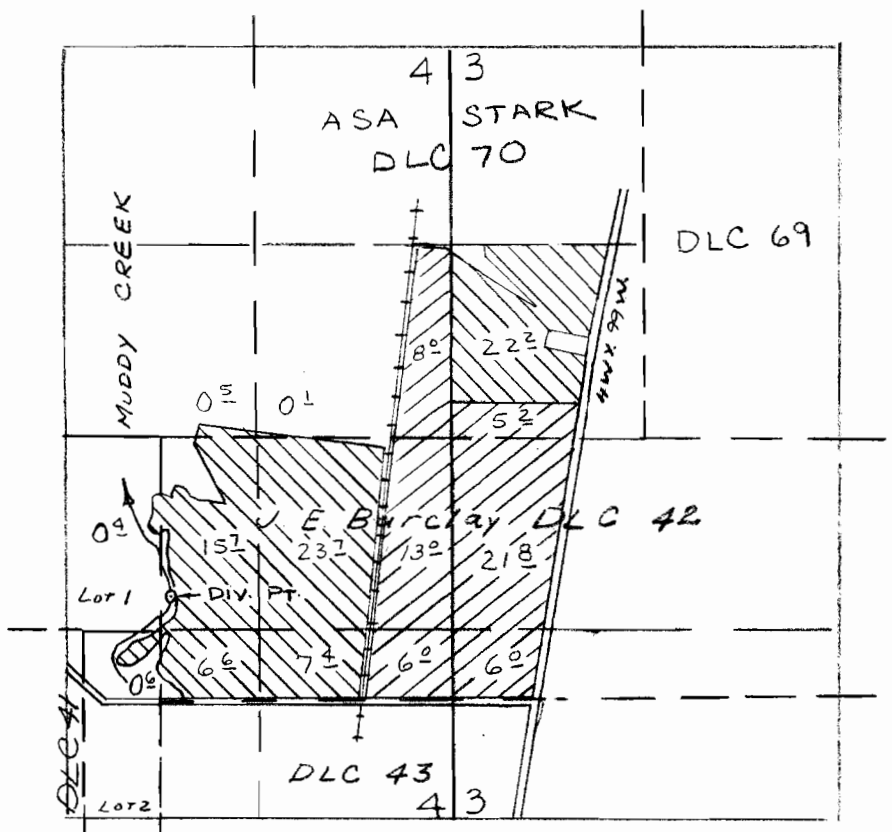
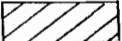


T. 14 S. R. 5 W. W. M.

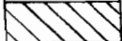

DIV. PT. LOC: 1075'S. & 3125'W. FROM SE. COR. D.C. 70

 Priority Feb 17, 1950

 Priority Mar 15, 1965