


T. 35S.R. 4W.W.M.

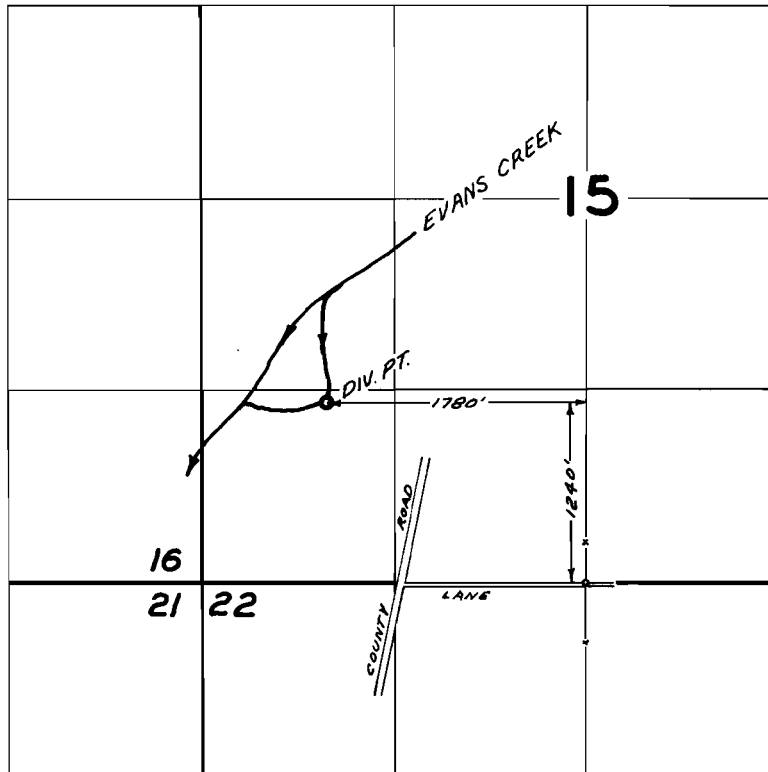

FINAL PROOF SURVEY
UNDER

TRANSFER No. H-174
Application No. Permit No.
IN NAME OF

J. IVAN HALL

Surveyed *JUN. 6* 1968, by *V. GARNER*