


T. 9 S. R. 4 0 E. W. M. .

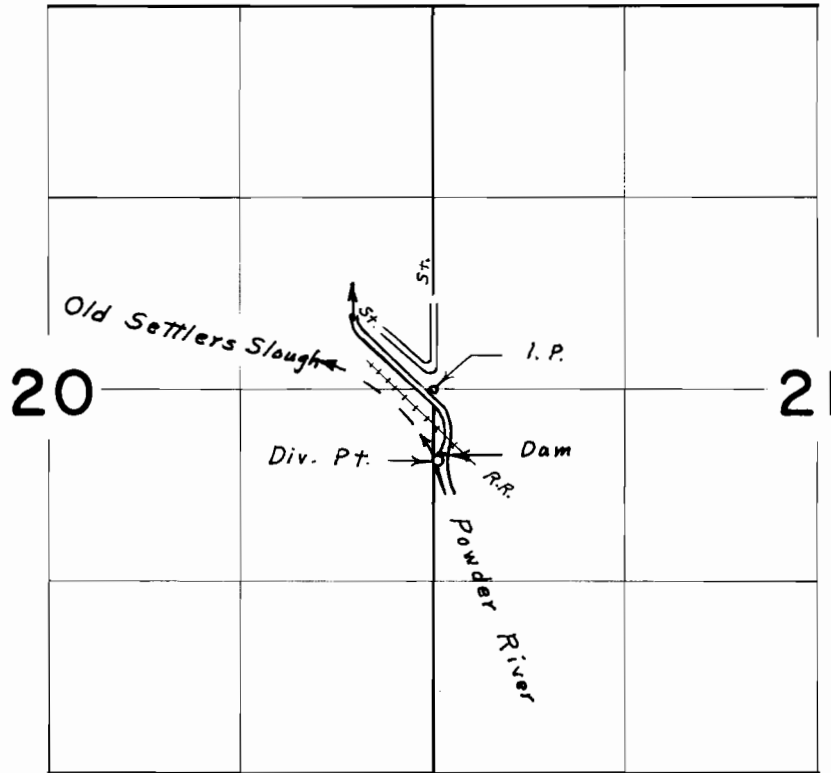

Div. Pt. located 480' S. & 30' E. from W. $\frac{1}{4}$ Cor. Sec. 21

FINAL PROOF SURVEY
UNDER

Application No. _____ Transfer No. H-176
Permit No. _____

IN NAME OF

PAUL HILL

Surveyed July 23, 1970, by L. E. Gould.