


T.18S., R.13E., W.M.

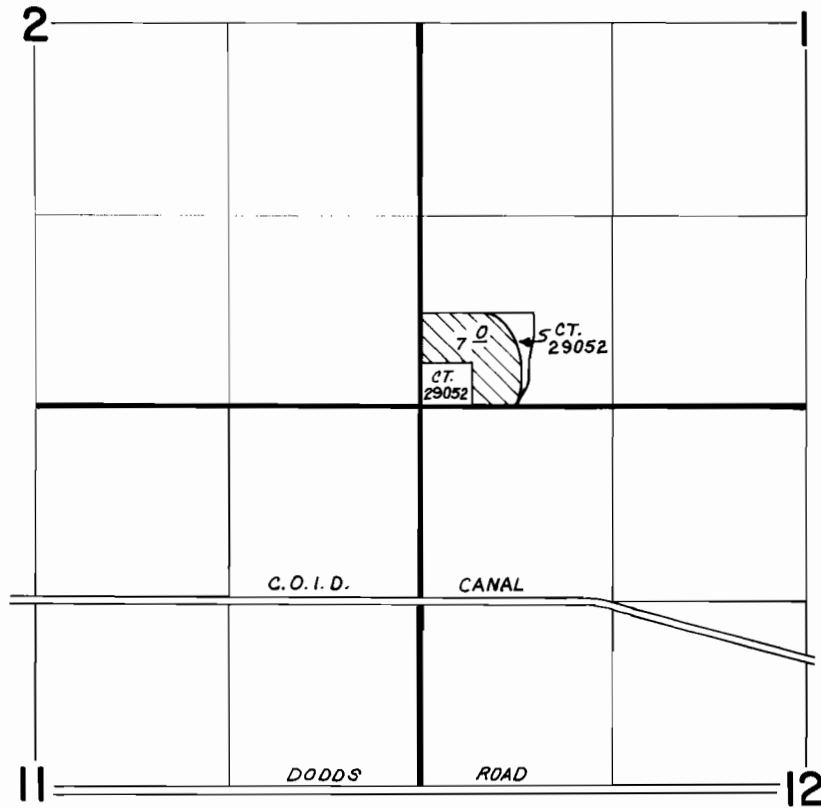

SCALE: 1" = 1320'

FINAL PROOF SURVEY UNDER

TRANSFER NO. H-186
Application No. Permit No.
IN NAME OF

ALEXANDER ALBERTINE / C.O.I.D.

Surveyed SEPT. 20, 1984, by LESLIE OLSON.