


T.15S., R.10E., W.M.

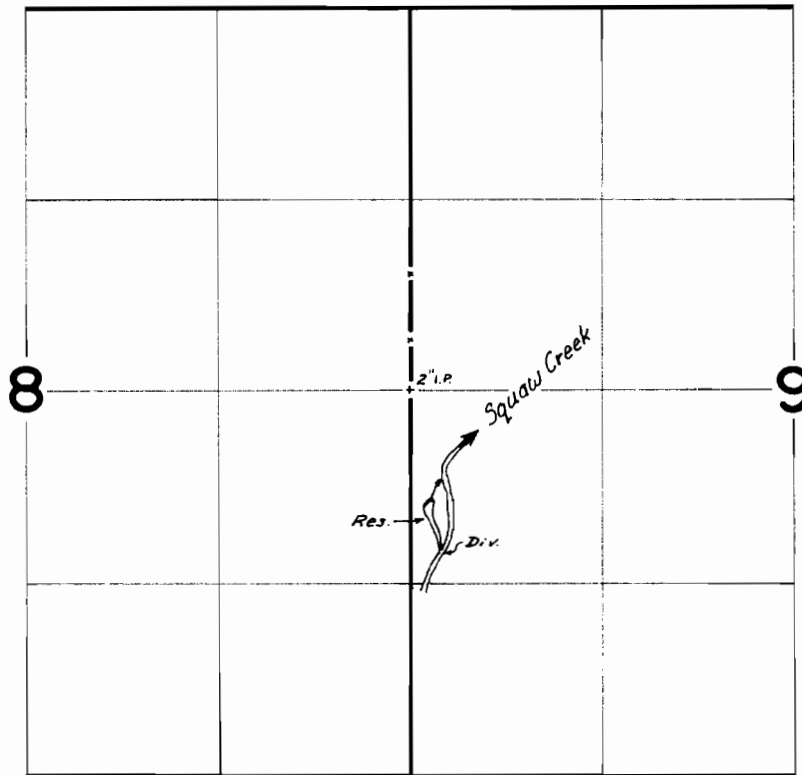

DIV. PTS. LOC: CR. - 1100'S & 210'E; RES. - 750'S & 140'E FROM
W 1/4 COR. SEC. 9.

FINAL PROOF SURVEY
UNDER

Transfer No. H-190
Application No. R-45225 Permit No. R-5315
IN NAME OF

.....
Surveyed Oct. 30 1975, by D. Norby