


T. 14 S. R. 8 W. W. M.

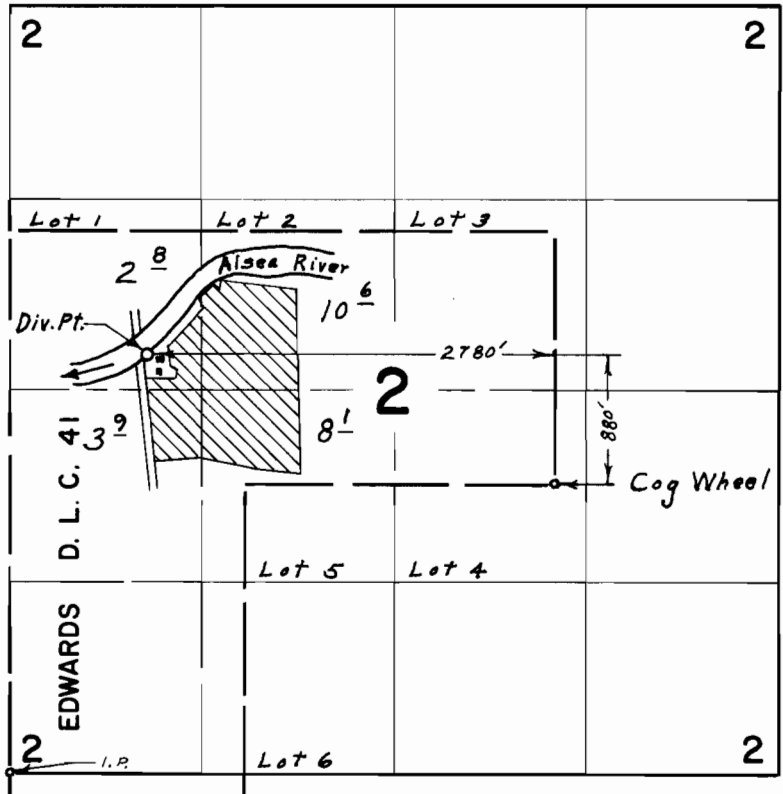

FINAL PROOF SURVEY UNDER

Transfer No. H-191
 Application No. Permit No.
 IN NAME OF

DONALD LEE & KATHLEEN ROSE BOATWRIGHT

Surveyed Aug. 21, 1970, by L. E. Gould.