


PLAT NO. 100
FILE NO. 100
DATE OF RECORDATION
BY

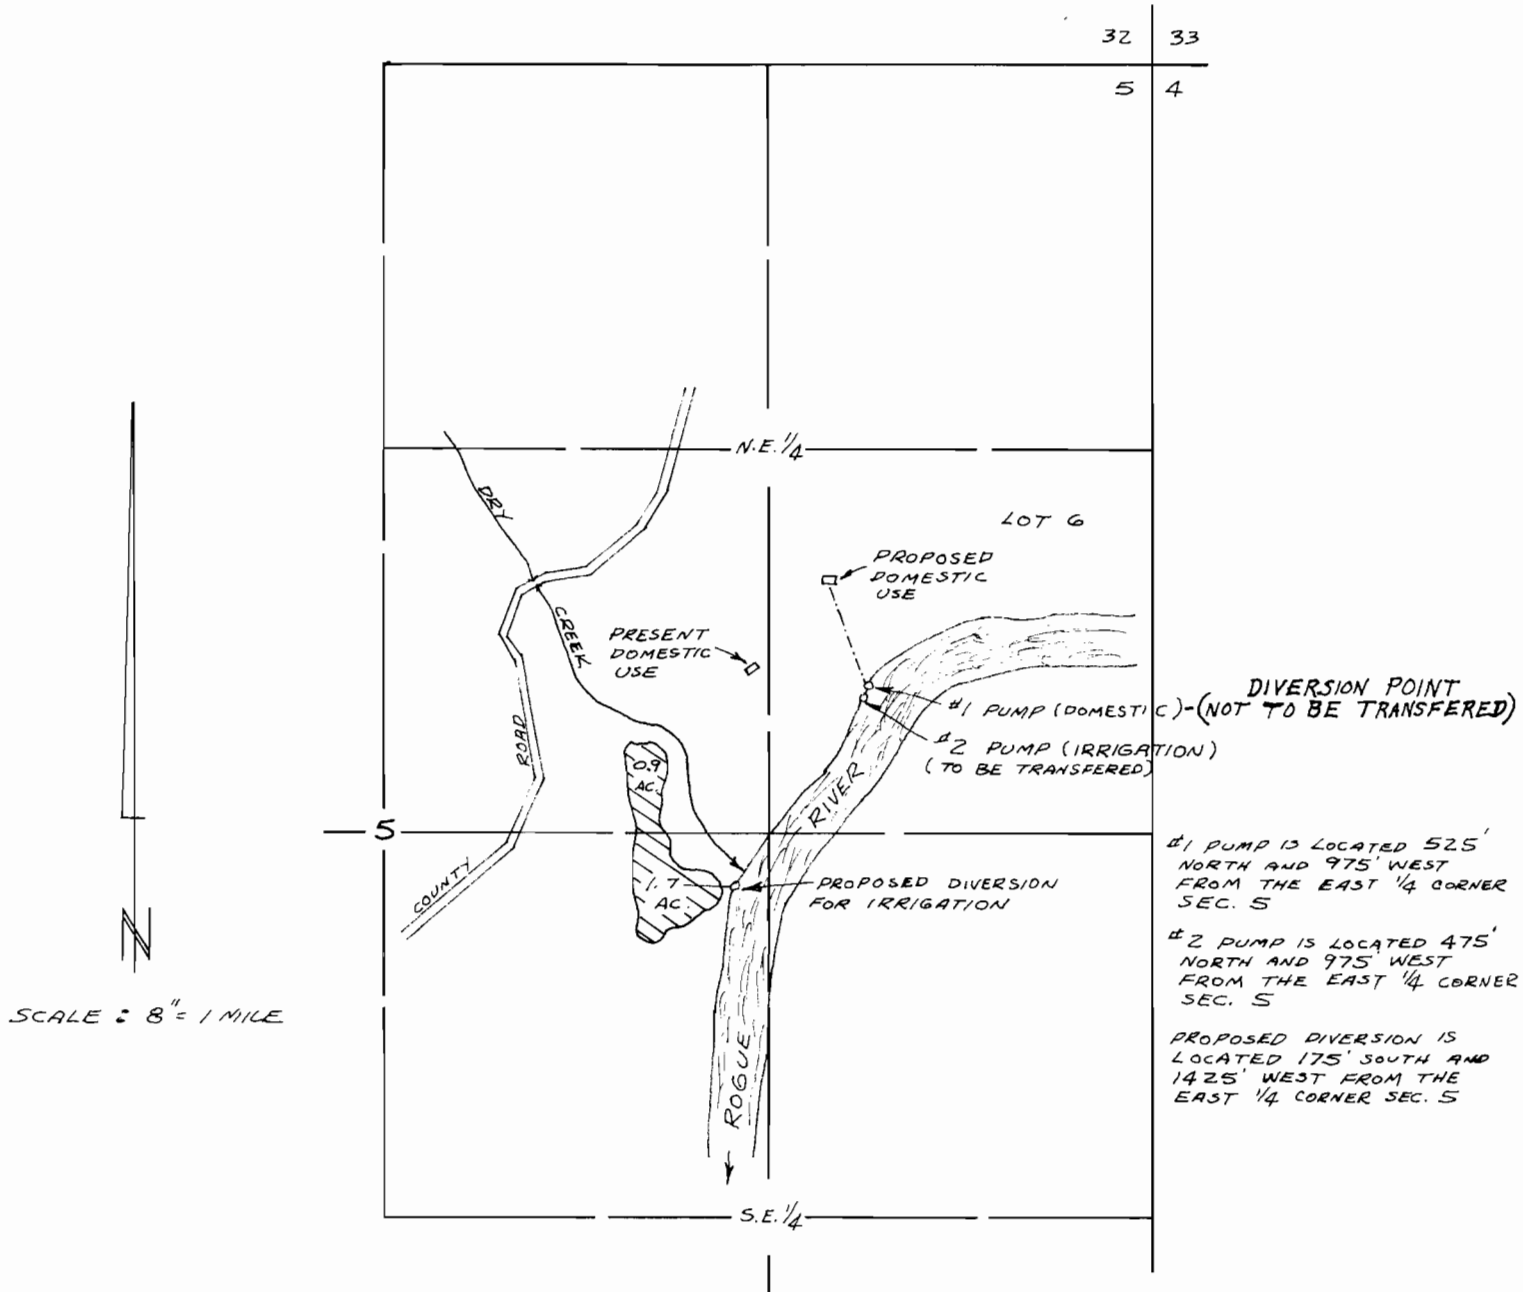

MAP TO ACCOMPANY APPLICATION OF MR. & MRS. J.E. HANNAH FOR A CHANGE IN PLACE OF USE OF DOMESTIC AND CHANGE IN POINT OF DIVERSION OF WATER FROM ROGUE RIVER.

AUGUST 14, 1969