


T.1S.,R.43E.,W.M.

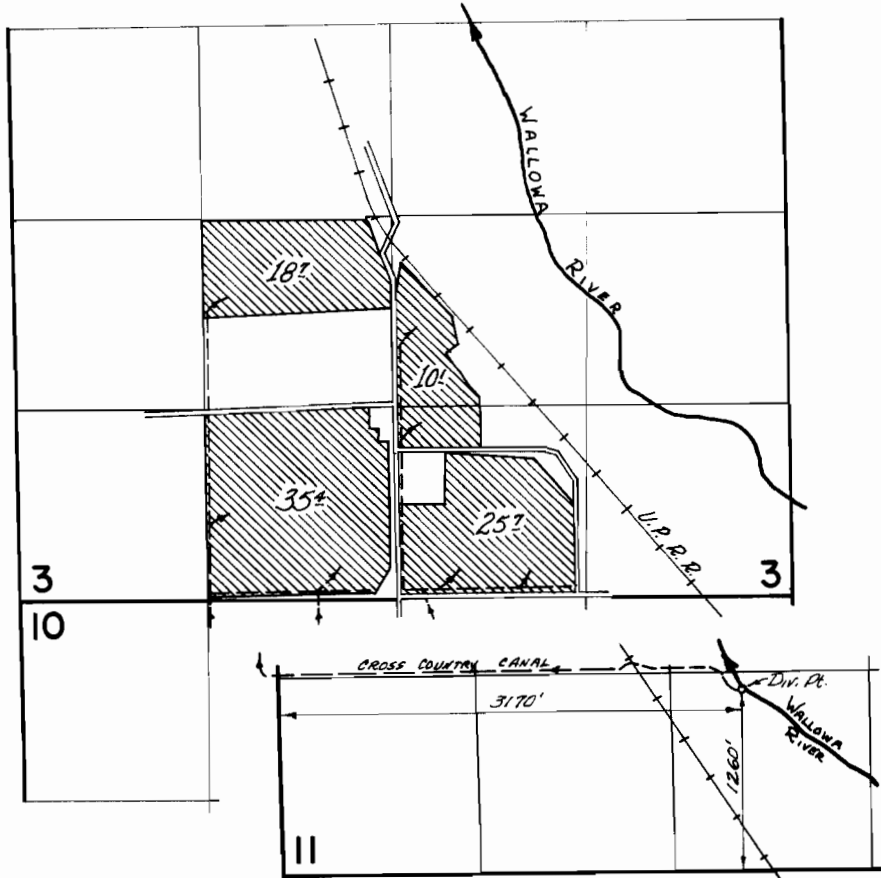

FINAL PROOF SURVEY
UNDER

Transfer No. H-200

Application No. 46551 Permit No. 34777

IN NAME OF

HAUN BROTHERS (JOSEPH & JAMES HAUN)

Surveyed Aug. 9 1973, by D. Norby