


T.28S.R.14W.W.M.

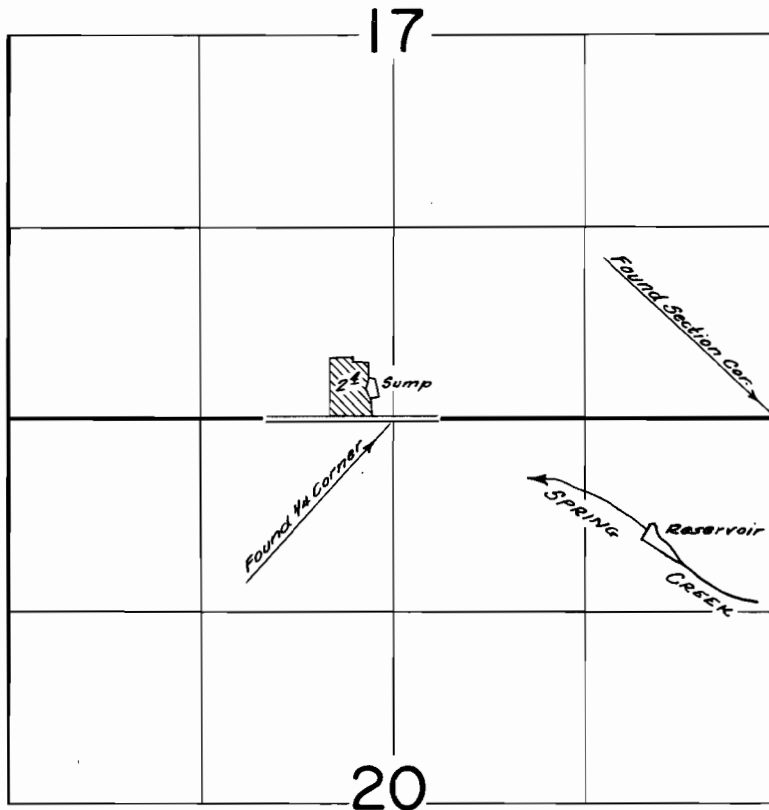

FINAL PROOF SURVEY
UNDER

Transfer No. 1-14

Application No. Permit No.
IN NAME OF

..... *H. R. INKS*

Surveyed Aug. 14, 1963, by *C. Baker*.....