


T.15 S. R.13 E.W.M  
DESCHUTES COUNTY

15 13  
& INDEX

1" = 2000' See Map 14 13

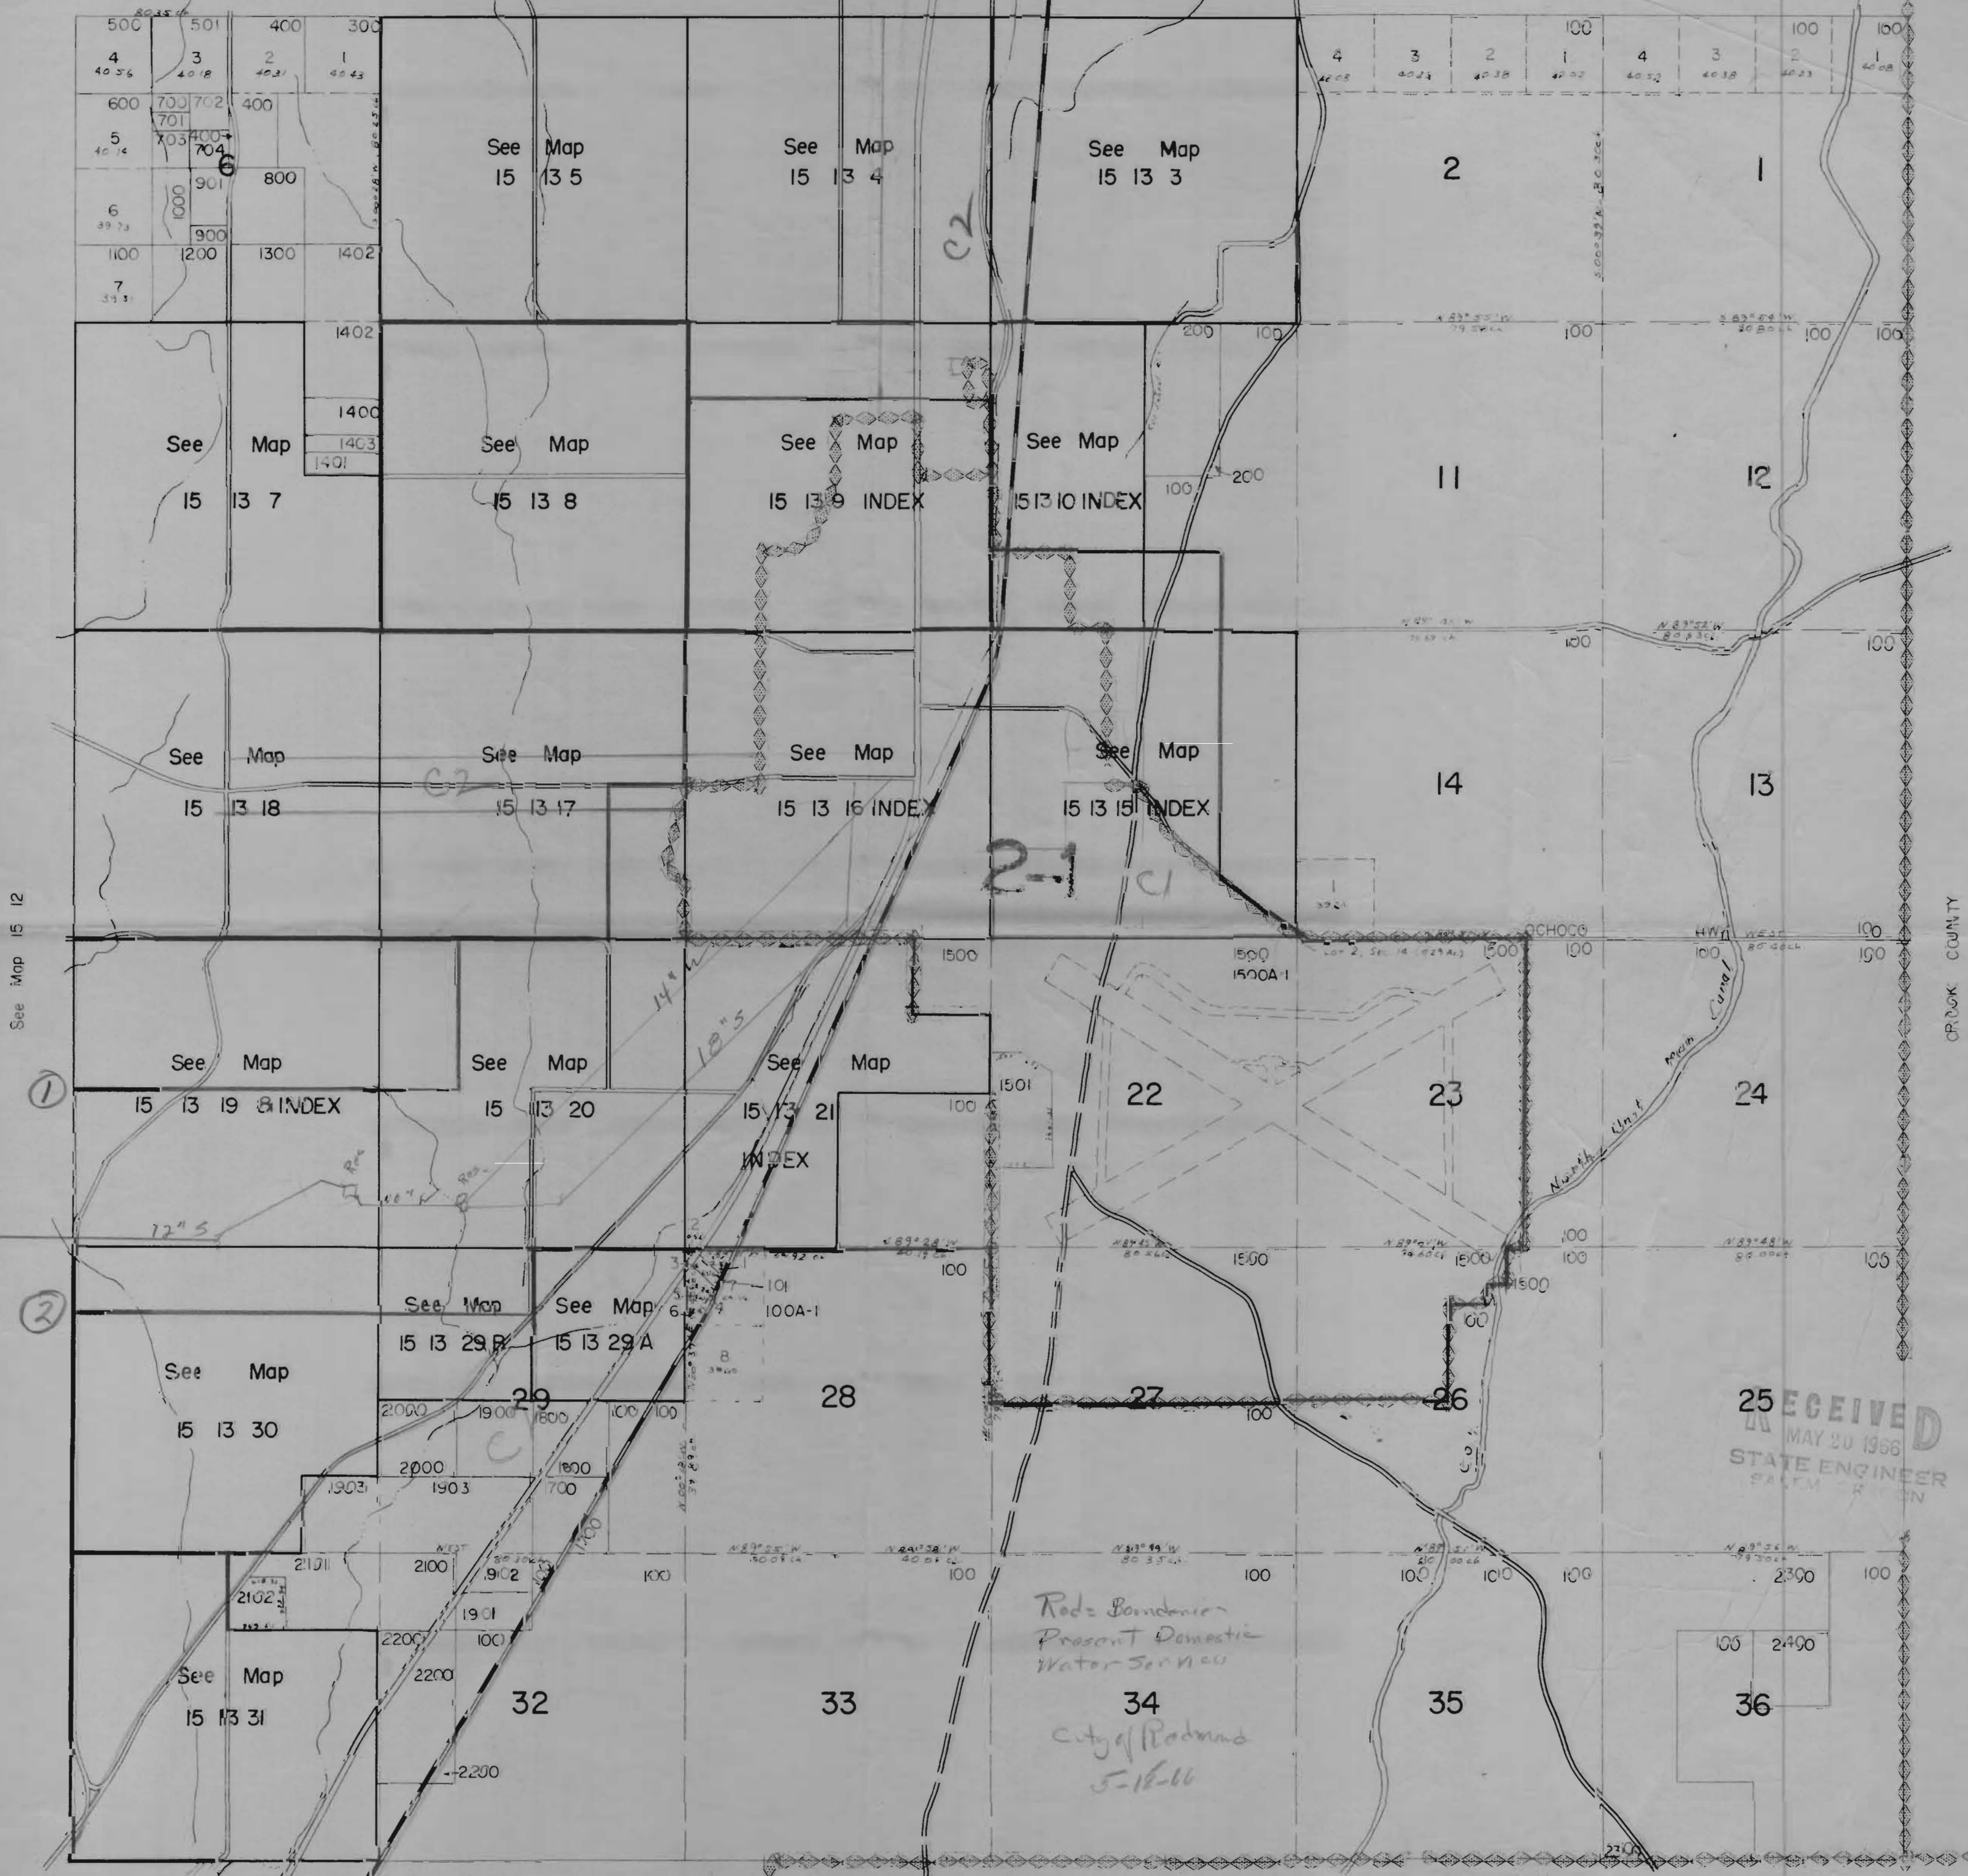

25 RECEIVED  
MAY 20 1966  
STATE ENGINEER  

Reds' Bordenian  
Present Domestic  
Water Service  
City of Redmond  
5-18-66

See Map 16 13

15 13  
& INDEX