


T. 34 S. R. 1 W. W.M.

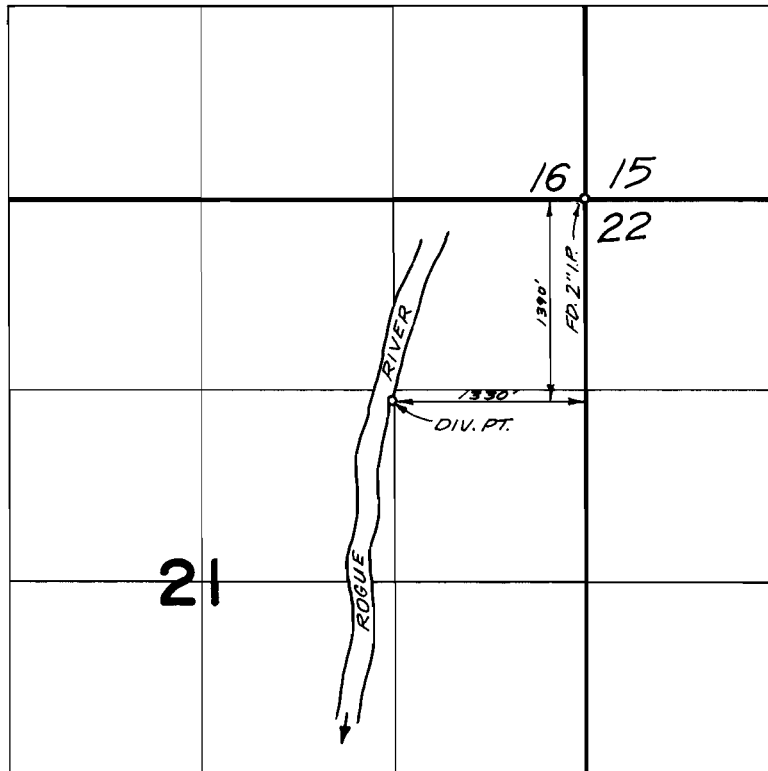

**FINAL PROOF SURVEY**  
UNDER

Transfer No. *H 192*  
Application No. .... Permit No. ....  
IN NAME OF

.....*MYRON DOYLE*.....

Surveyed *July 31, 1974*, by *D. NORBY*.....