


4

TOWNSHIP 36 S, RANGE 4 W, W. M.

North

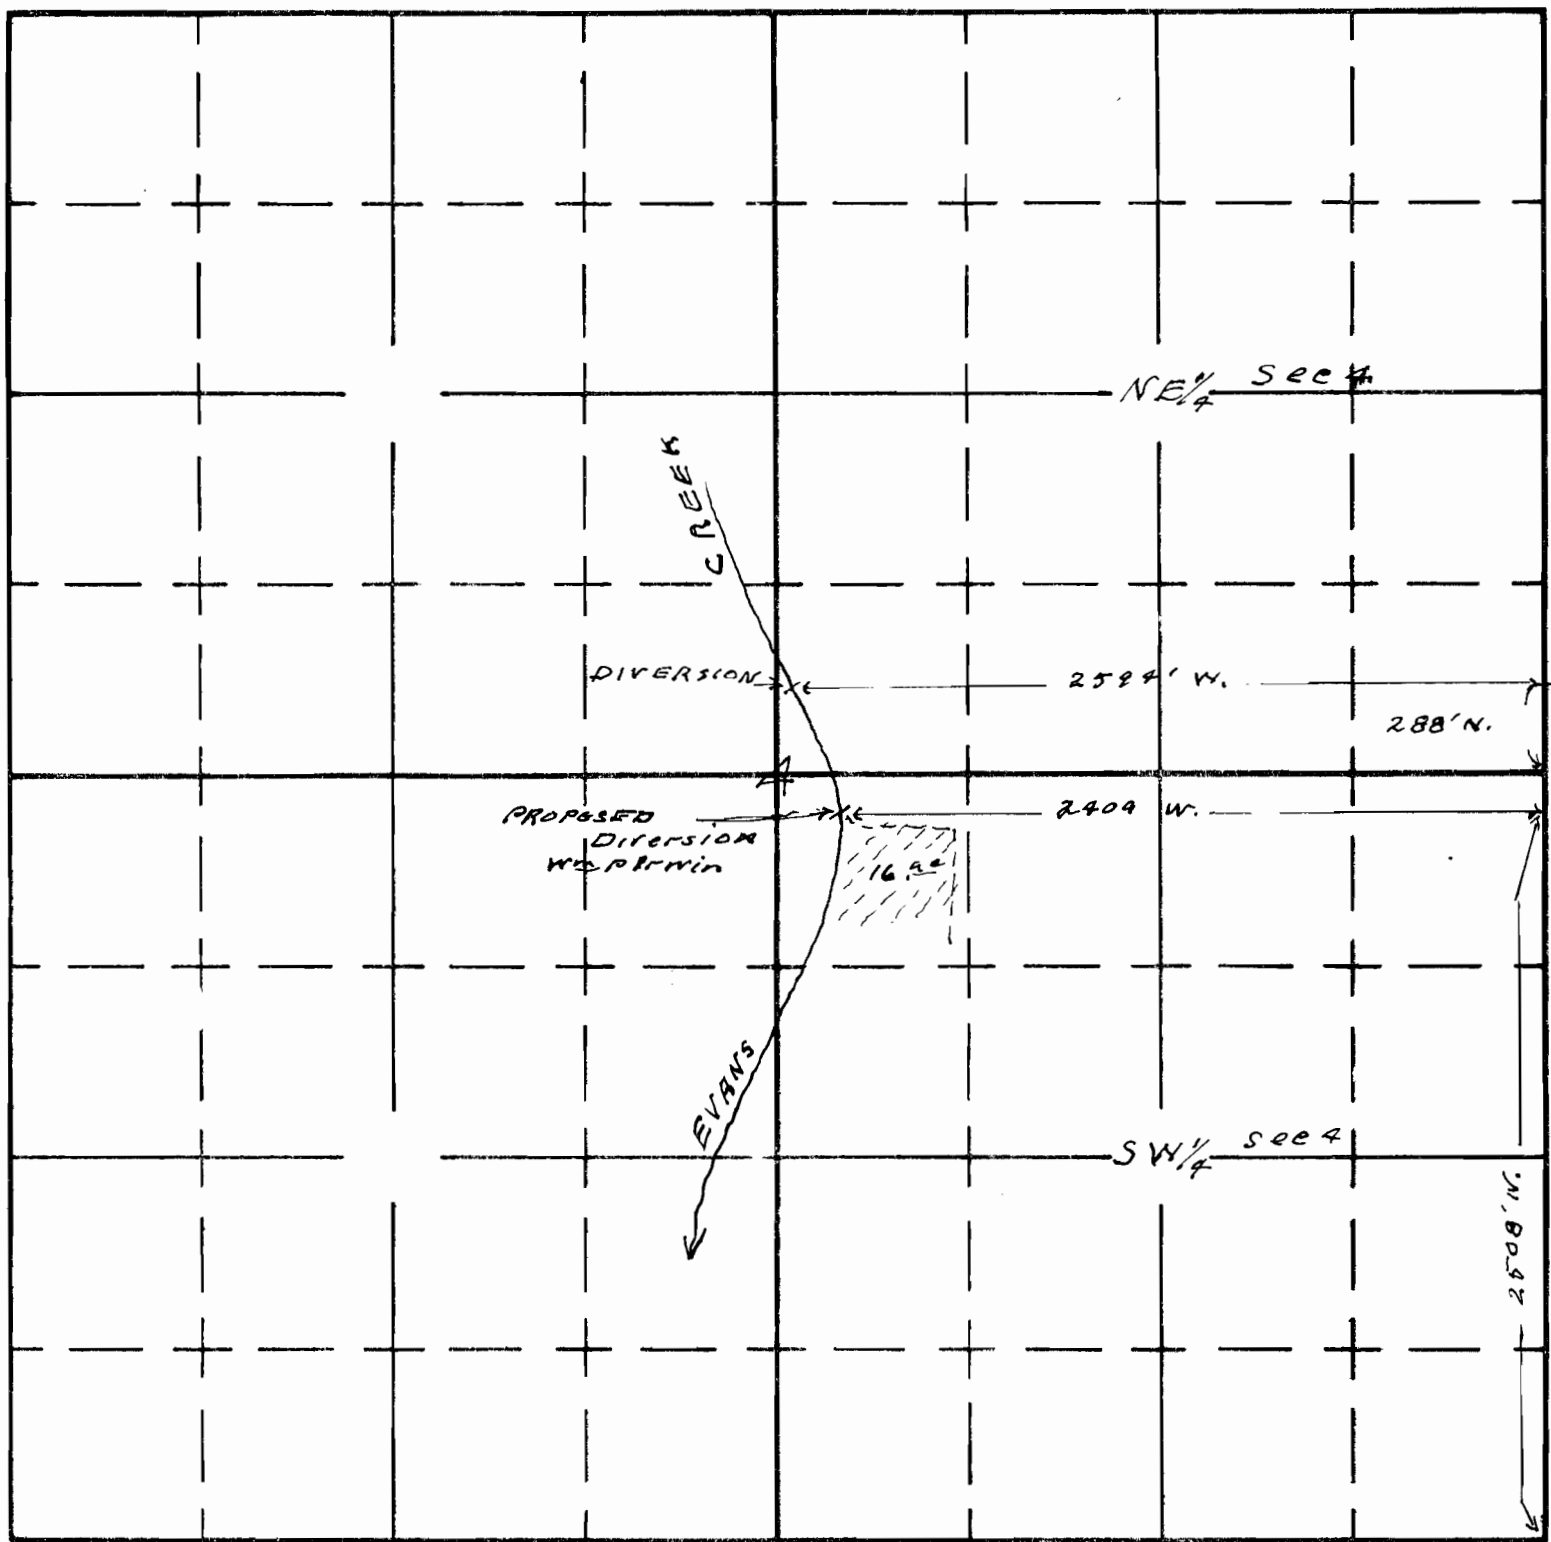

South

Map to accompany application of  
Wm Price Irwin for change in point  
of diversion

Corrected  
MAP

This office 4/28/45 *Atkins*