


T. 78 & 8 S. R. 3 W. W.M.

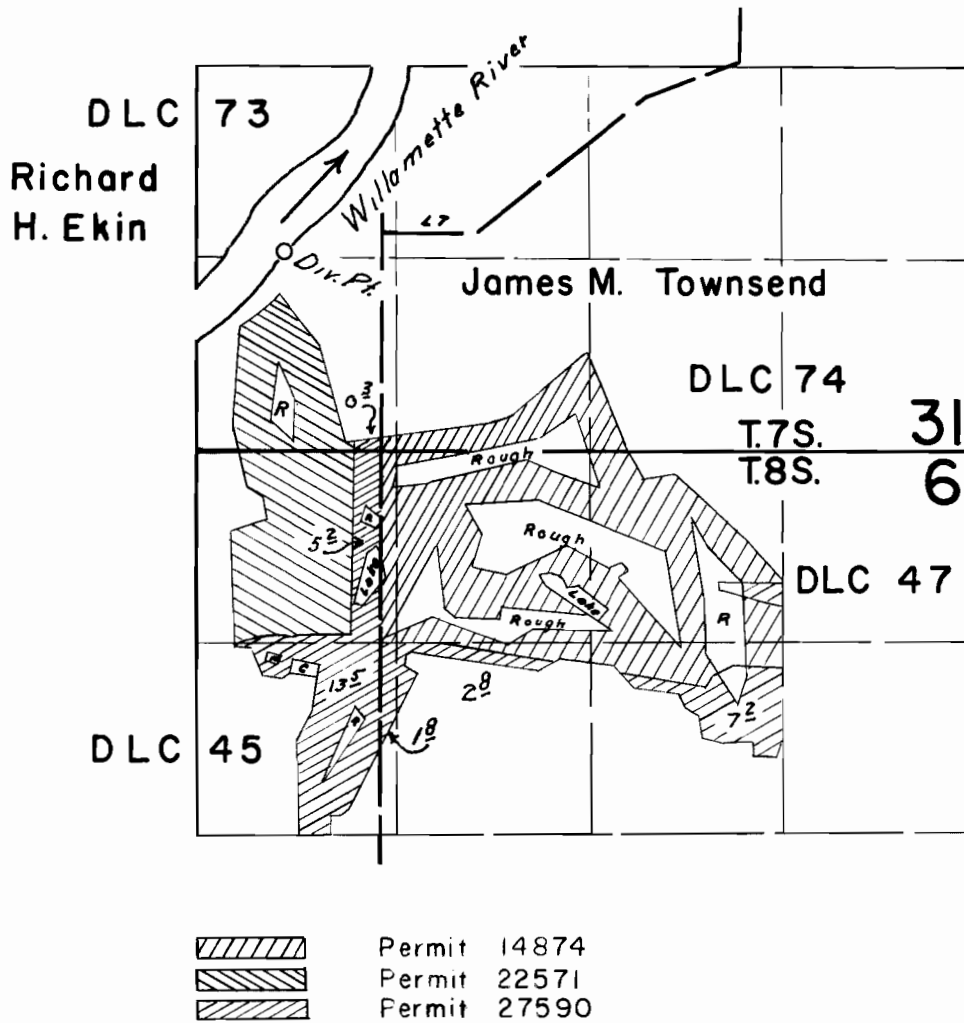

FINAL PROOF SURVEY
UNDER

Application No. 35523 Permit No. 27590
IN NAME OF

ILLAHE HILLS COUNTRY CLUB

Surveyed Oct. 13, 14, 1964, by C.J. Gardner.....