


T.I.S.R.13E.W.M.

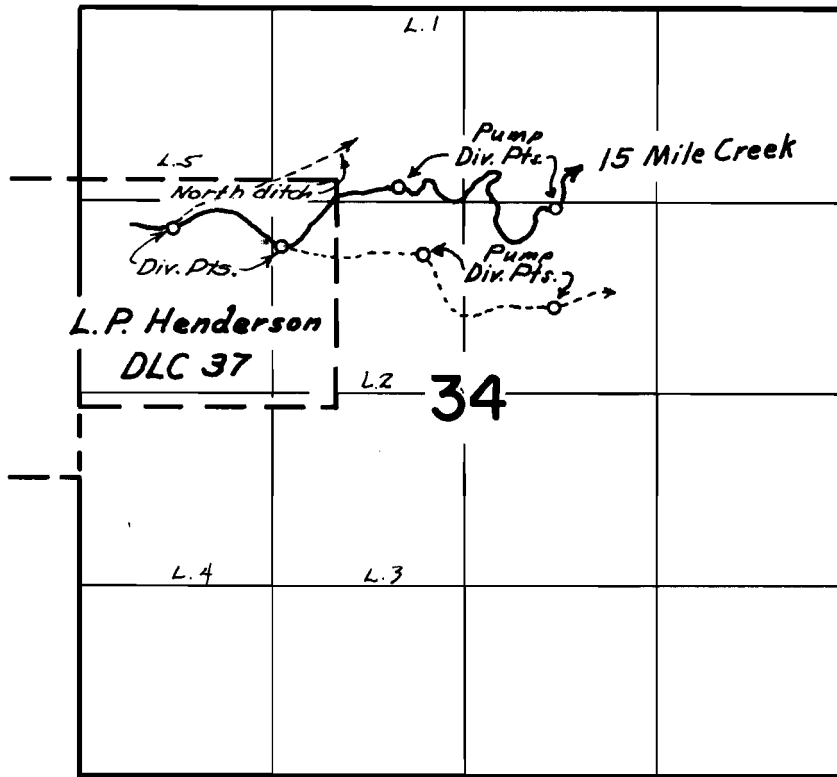

FINAL PROOF SURVEY
UNDER

Transfer No. I-15
IN NAME OF

James S. Ingles

Surveyed April 18, 1962, by Thomas B. Lauer