


Walla Walla River Irrigation District

3201 Water Rights Map

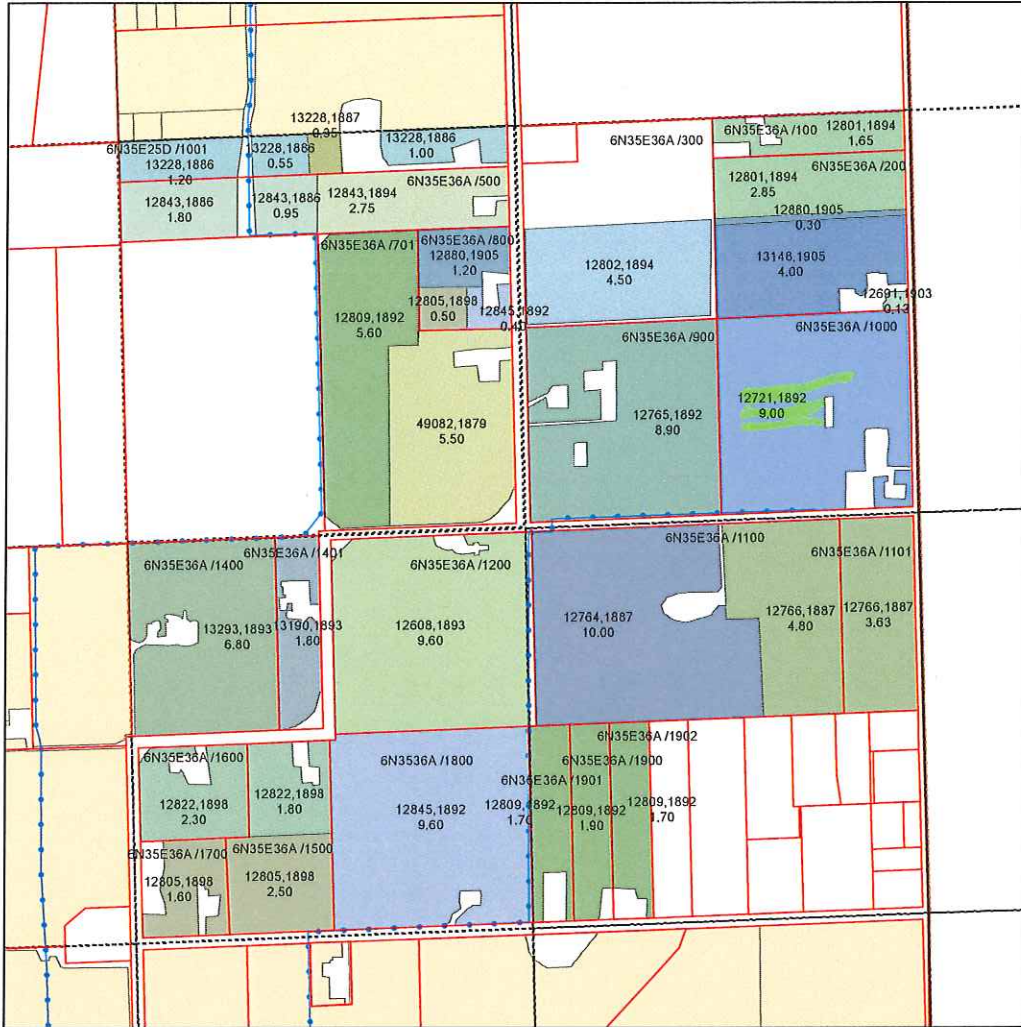

T6N R35E WM Section 36 NE Quarter

Primary Certificates

CERTIFICATE, PRIORITY


- 12608, 1893
- 12691, 1903
- 12721, 1892
- 12764, 1887
- 12765, 1892
- 12766, 1887
- 12801, 1894
- 12802, 1894
- 12805, 1898
- 12809, 1892
- 12822, 1898
- 12843, 1886
- 12843, 1894
- 12845, 1892
- 12880, 1905
- 13148, 1905
- 13190, 1893
- 13228, 1886
- 13228, 1887
- 13293, 1893
- 49082, 1879
- Water Rights Not Within Quarter

ASSESSORMAP	CERTIFICATE	PRIORITY	QQ	WR ACRES
6N35E25D/1001	13228	1886	NWNE	1.20
6N35E25D/1001	13228	1886	NWNE	1.00
6N35E25D/1001	13228	1886	NWNE	0.55
6N35E25D/1001	13228	1887	NWNE	0.35
6N35E36A/100	12801	1894	NENE	1.65
6N35E36A/1000	12721	1892	NENE	9.00
6N35E36A/1100	12764	1887	SENE	10.00
6N35E36A/1100	12766	1887	SENE	4.80
6N35E36A/1101	12766	1887	SENE	3.63
6N35E36A/1200	12608	1893	SWNE	9.60
6N35E36A/1400	13293	1893	SWNE	6.80
6N35E36A/1401	13190	1893	SWNE	1.80
6N35E36A/1500	12805	1898	SWNE	2.50
6N35E36A/1600	12822	1898	SWNE	1.80
6N35E36A/1700	12805	1898	SWNE	1.60
6N35E36A/1800	12845	1892	SWNE	9.60
6N35E36A/1900	12809	1892	SENE	1.90
6N35E36A/1901	12809	1892	SENE	1.70
6N35E36A/1902	12809	1892	SENE	1.70
6N35E36A/200	12691	1903	NENE	0.13
6N35E36A/200	12801	1894	NENE	2.85
6N35E36A/200	12880	1905	NENE	0.30
6N35E36A/200	13148	1905	NENE	4.00
6N35E36A/300	12802	1894	NENE	4.50
6N35E36A/500	12843	1886	NWNE	1.80
6N35E36A/500	12843	1886	NWNE	0.95
6N35E36A/500	12843	1894	NWNE	2.75
6N35E36A/701	12809	1892	NWNE	5.60
6N35E36A/701	49082	1879	NWNE	5.50
6N35E36A/800	12805	1898	NWNE	0.50
6N35E36A/800	12845	1892	NWNE	0.40
6N35E36A/800	12880	1905	NWNE	1.20
6N35E36A/900	12765	1892	NENE	8.90



Legend

- PIPE
- Parcel
- QCDB
- WWRID Boundary

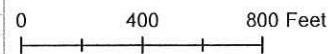


Date Jan 2009

90657

Walla Walla River Irrigation District

3201 Water Rights Map

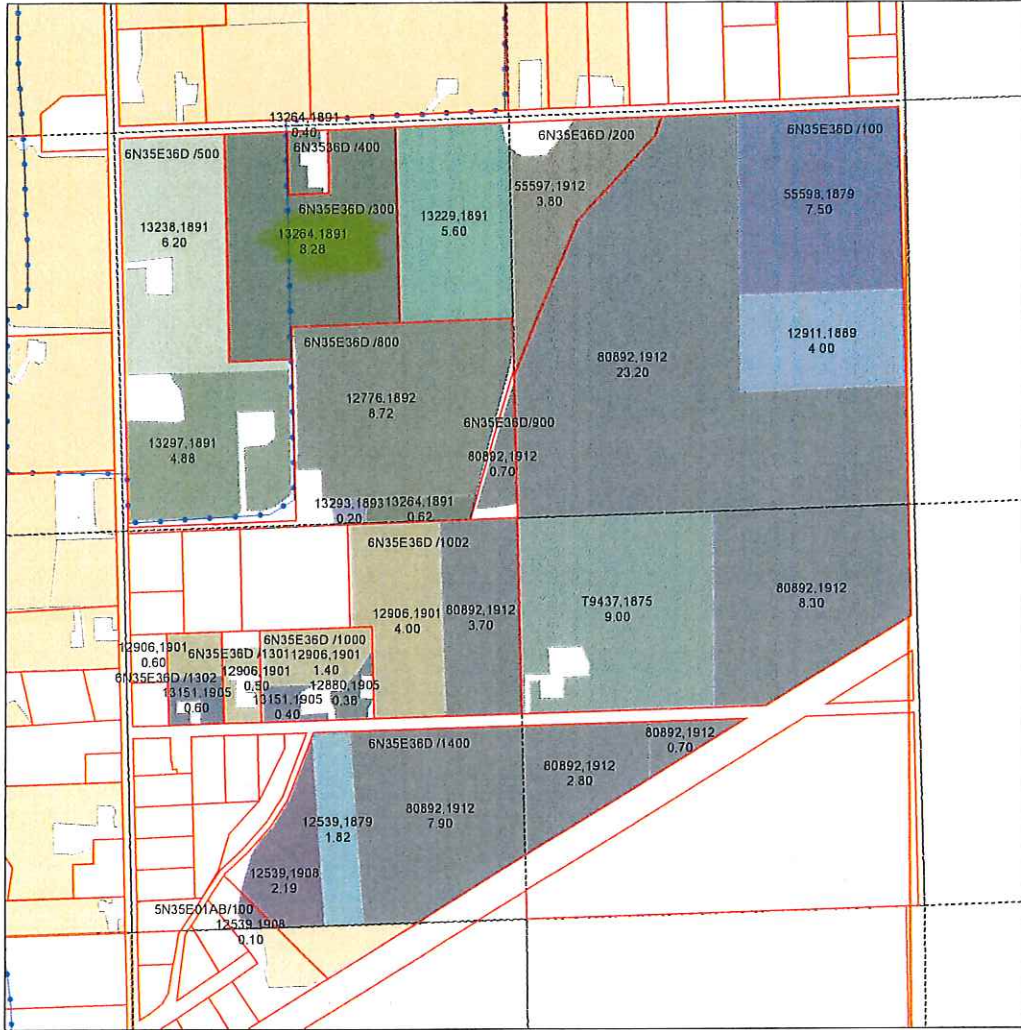

T6N R35E WM Section 36 SE Quarter


Primary Certificates
CERT, PRIORITY

- 12539, 1879
- 12539, 1908
- 12776, 1892
- 12880, 1905
- 12906, 1901
- 12911, 1889
- 13151, 1905
- 13229, 1891
- 13238, 1891
- 13264, 1891
- 13293, 1893
- 13297, 1891
- 55597, 1912
- 55598, 1879
- 80892, 1912
- T9437, 1875
- Water Rights Not Within Quarter

ASSESSORMAP	CERTIFICATE	PRIORITY	QQ	WR ACRES
5N35E01AB/100	12539	1908	SWSE	0.10
6N35E36A/400	13264	1891	NWSE	0.40
6N35E36A/800	12776	1892	NWSE	8.72
6N35E36A/800	13264	1891	NWSE	0.62
6N35E36A/800	13293	1893	NWSE	0.20
6N35E36D/100	12911	1889	NESE	4.00
6N35E36D/100	55598	1879	NESE	7.50
6N35E36D/100	80892	1912	NESE	23.20
6N35E36D/100	80892	1912	SESE	8.30
6N35E36D/100	T9437	1875	SESE	9.00
6N35E36D/1000	12880	1905	SWSE	0.38
6N35E36D/1000	12906	1901	SWSE	1.40
6N35E36D/1000	13151	1905	SWSE	0.40
6N35E36D/1002	12906	1901	SWSE	4.00
6N35E36D/1002	80892	1912	SWSE	3.70
6N35E36D/1301	12906	1901	SWSE	0.50
6N35E36D/1302	12906	1901	SWSE	0.60
6N35E36D/1302	13151	1905	SWSE	0.60
6N35E36D/1400	12539	1879	SWSE	1.82
6N35E36D/1400	12539	1908	SWSE	2.19
6N35E36D/1400	80892	1912	SESE	0.70
6N35E36D/1400	80892	1912	SWSE	7.90
6N35E36D/1400	80892	1912	SESE	2.80
6N35E36D/200	13229	1891	NWSE	5.60
6N35E36D/200	55597	1912	NESE	3.80
6N35E36D/300	13264	1891	NWSE	8.28
6N35E36D/500	13238	1891	NWSE	6.20
6N35E36D/500	13297	1891	NWSE	4.88
6N35E36D/900	80892	1912	NWSE	0.70


Legend

- PIPE
- Parcel
- QCDB
- WWRID Boundary

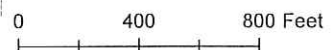

Walla Walla River Irrigation District

3201 Water Rights Map

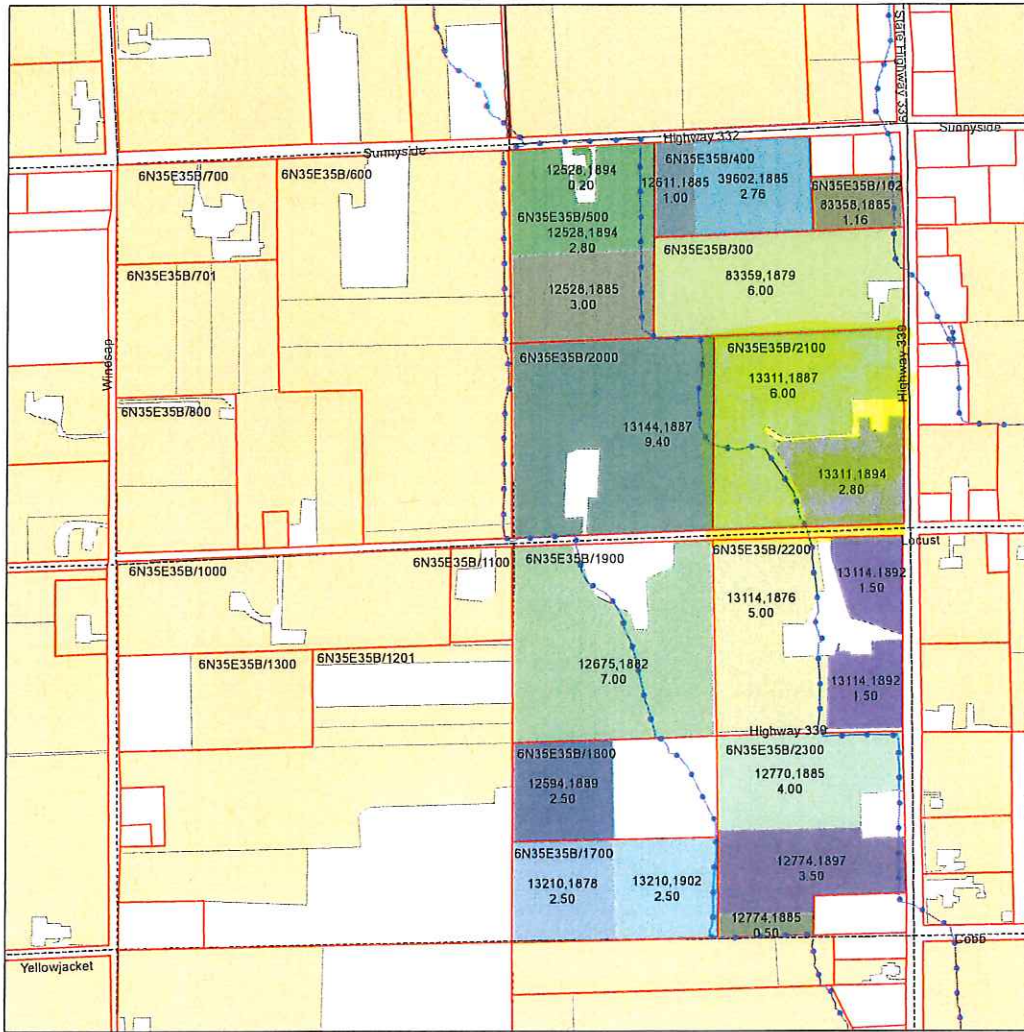

Primary Certificates T6N R35E WM Section 35 E1/2 NW Quarter


CERTIFICATE, PRIORITY

- 12528, 1885
- 12528, 1894
- 12594, 1889
- 12611, 1885
- 12675, 1882
- 12770, 1885
- 12774, 1885
- 12774, 1897
- 13114, 1876
- 13114, 1892
- 13144, 1887
- 13210, 1878
- 13210, 1902
- 13311, 1887
- 13311, 1894
- 39602, 1885
- 83358, 1885
- 83359, 1879
- Water Rights Not Within Quarter

ASSESSORMAP	CERTIFICATE	PRIORITY	QQ	WR ACRES
6N35E35B/102	83358	1885	NENW	1.16
6N35E35B/1700	13210	1902	SEnw	2.50
6N35E35B/1700	13210	1878	SEnw	2.50
6N35E35B/1800	12594	1889	SEnw	2.50
6N35E35B/1900	12675	1882	SEnw	7.00
6N35E35B/2000	13144	1887	NENw	9.40
6N35E35B/2100	13311	1887	NENw	6.00
6N35E35B/2100	13311	1894	NENw	2.80
6N35E35B/2200	13114	1876	SEnw	5.00
6N35E35B/2200	13114	1892	SEnw	1.50
6N35E35B/2200	13114	1892	SEnw	1.50
6N35E35B/2300	12770	1885	SEnw	4.00
6N35E35B/2300	12774	1897	SEnw	3.50
6N35E35B/2300	12774	1885	SEnw	0.50
6N35E35B/300	83359	1879	NENw	6.00
6N35E35B/400	39602	1885	NENw	2.76
6N35E35B/400	12611	1885	NENw	1.00
6N35E35B/500	12528	1894	NENw	0.20
6N35E35B/500	12528	1894	NENw	2.80
6N35E35B/500	12528	1885	NENw	3.00

Legend

- PIPE
- Parcel
- QCDB
- WWRID Boundary

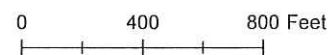

Date March 2011

92474