


T.11S., R.4W., W.M.

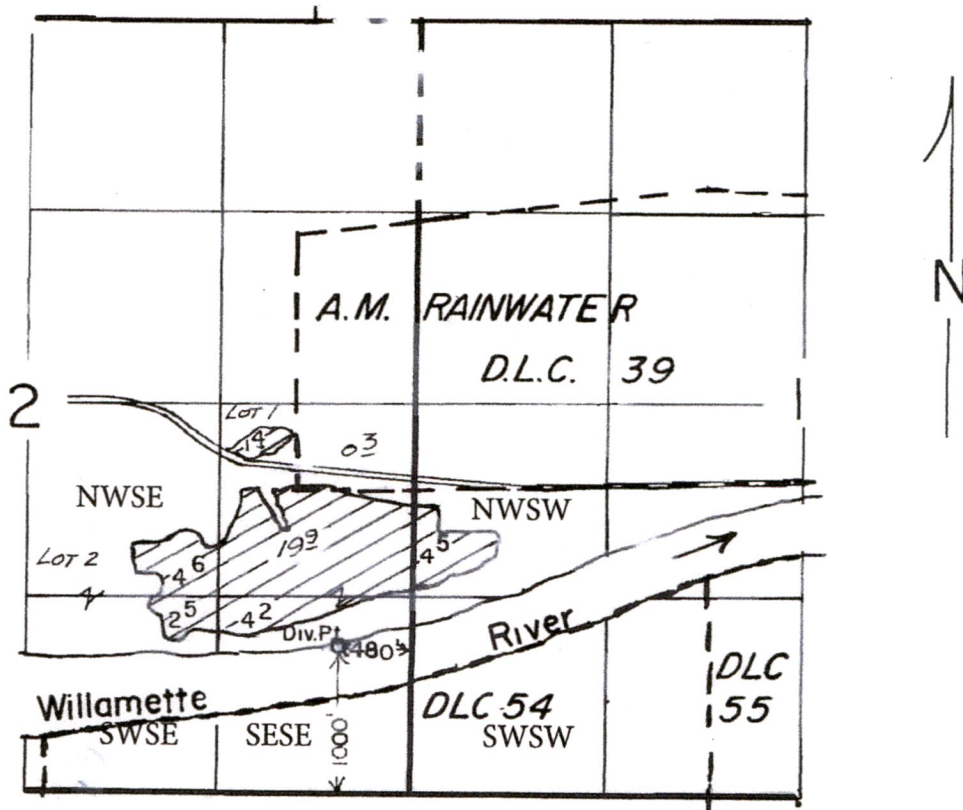

SCALE: 1" = 1320'

FINAL PROOF SURVEY
UNDER

Application No. 51746... Permit No. 39000....
IN NAME OF

J.J. LOONEY ESTATE


Surveyed APRIL 29 1987., by T.M. WARREN.....

RECEIVED

OCT 21 2019

OWRD

THIS MAP WAS PREPARED FOR
ASSESSMENT PURPOSE ONLY

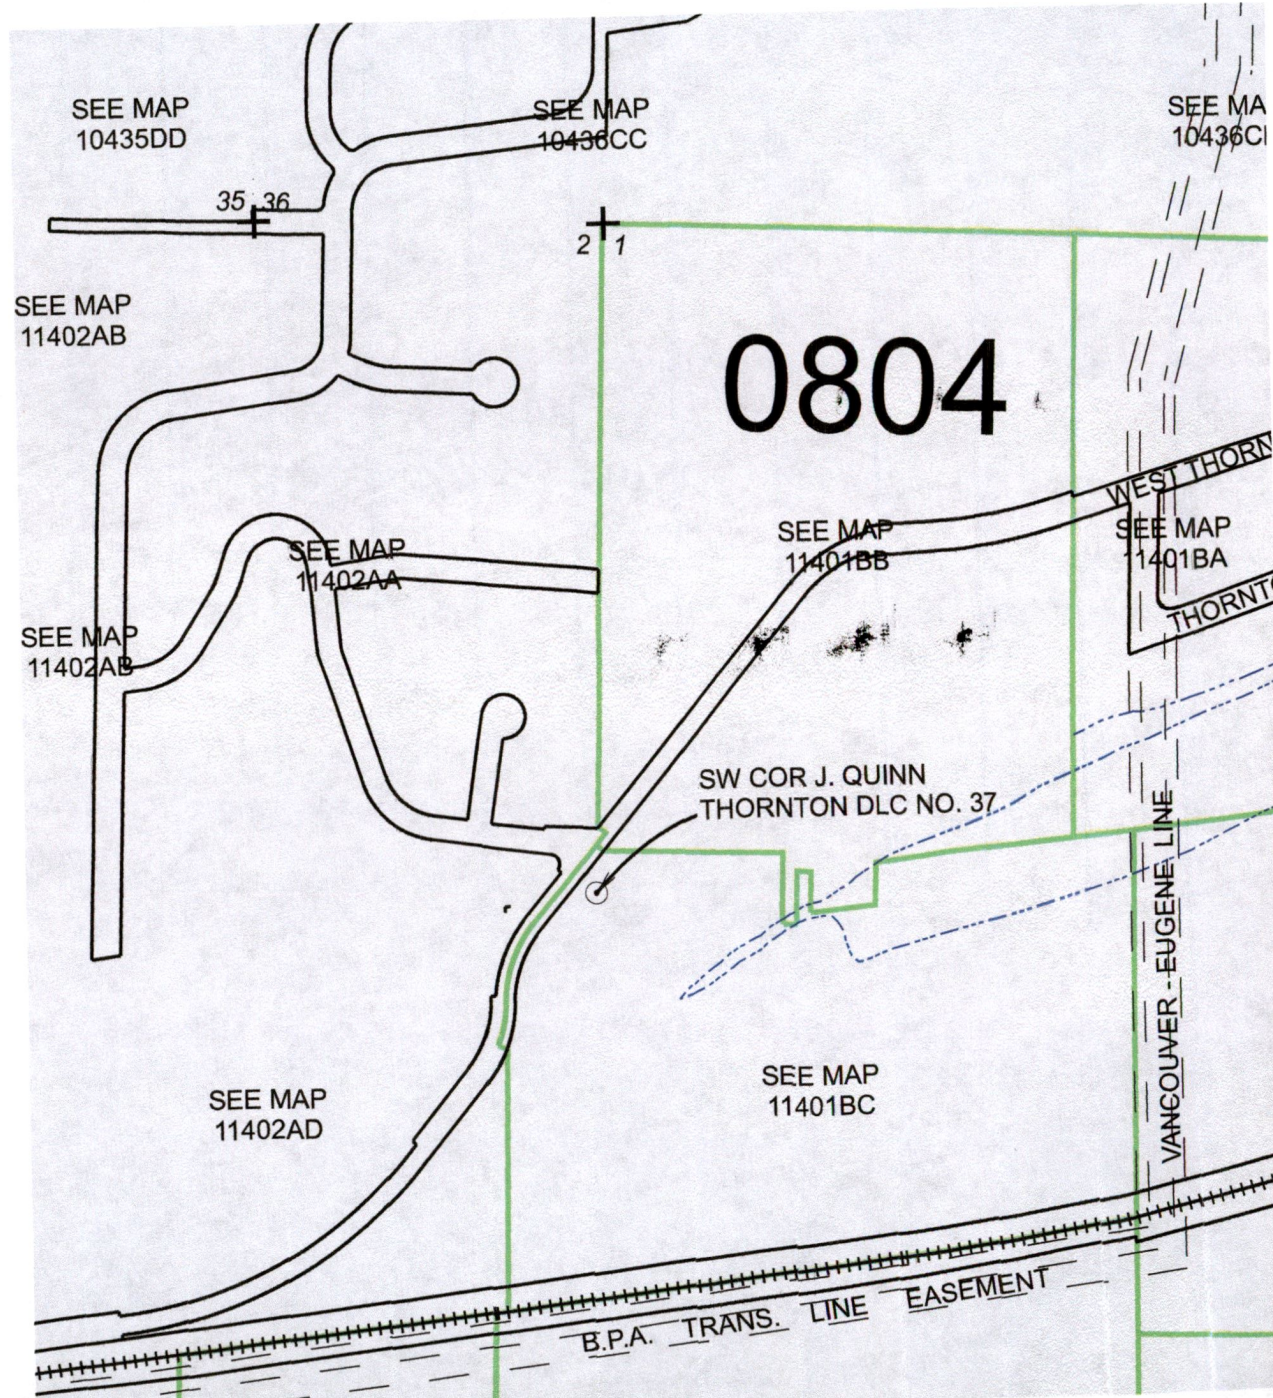

RECEIVED

OCT 21 2018

OWRD

