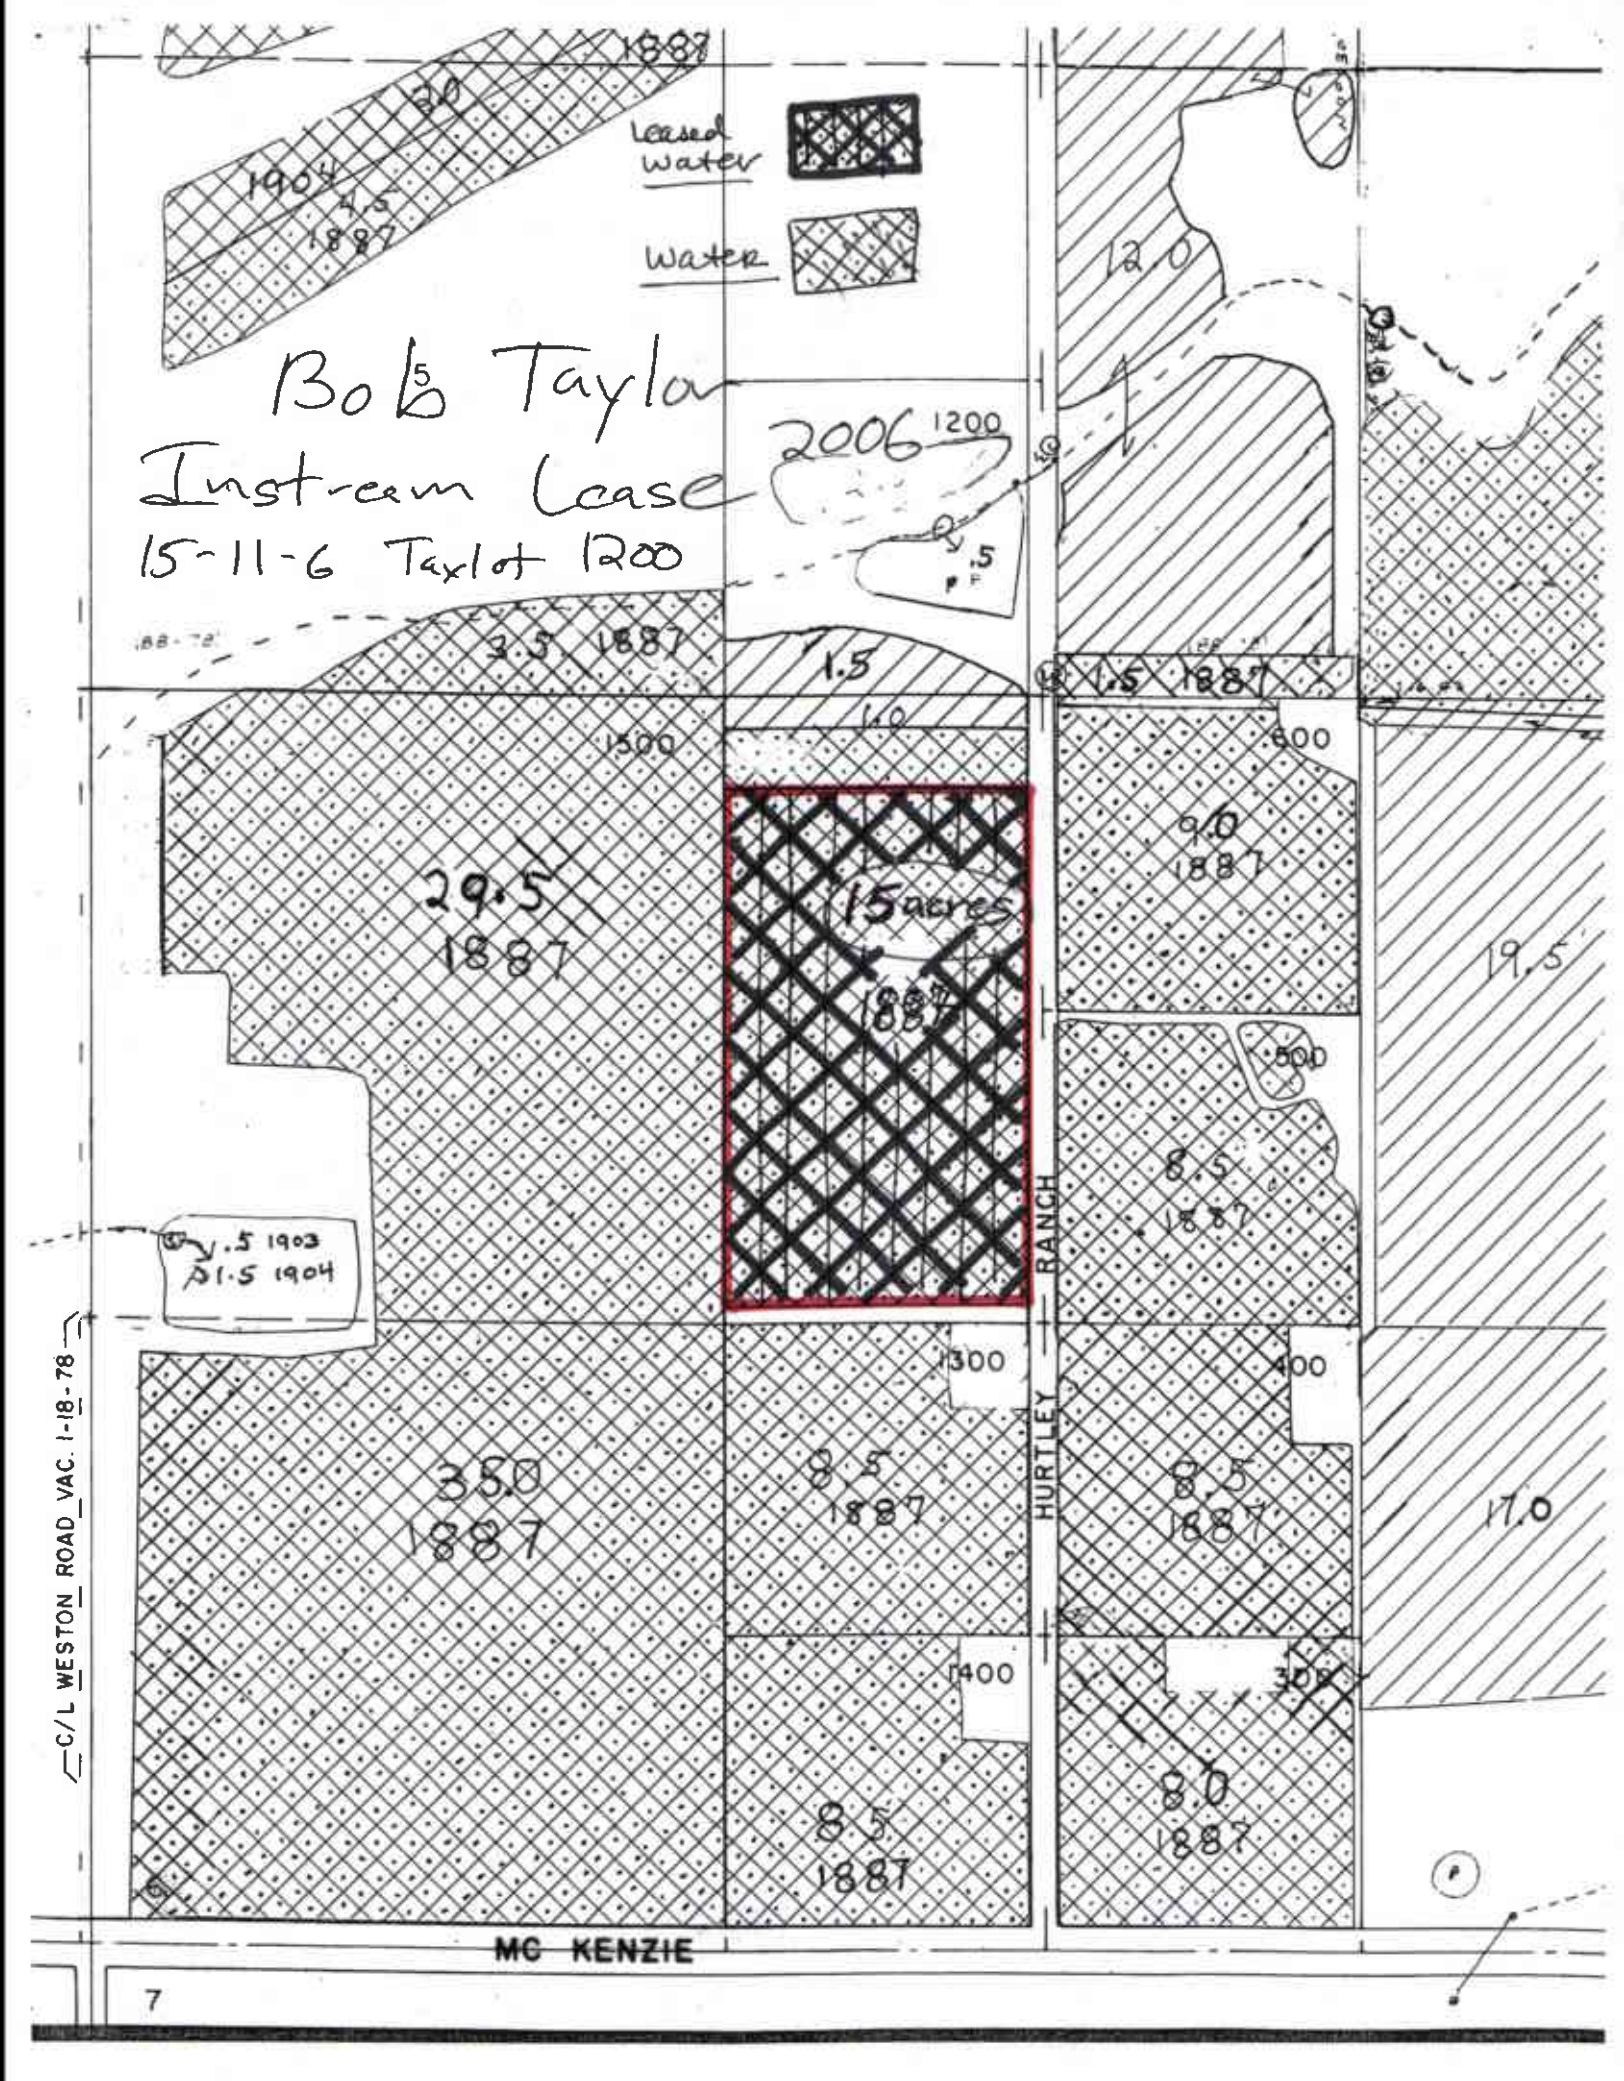
Leased Water
Water
Bob Taylor
Instream Lease
15-11-6 Taxlot 1200
2006
1200
15 acres
1887
29.5
1887
35.0
1887
8.5
1887
9.0
1887
19.5
17.0
12.0
HURTLEY RANCH
C/L WESTON ROAD VAC. 1-18-78
MC KENZIE
7