


Tax Lot 500

T.8S. R.6W.W.M.

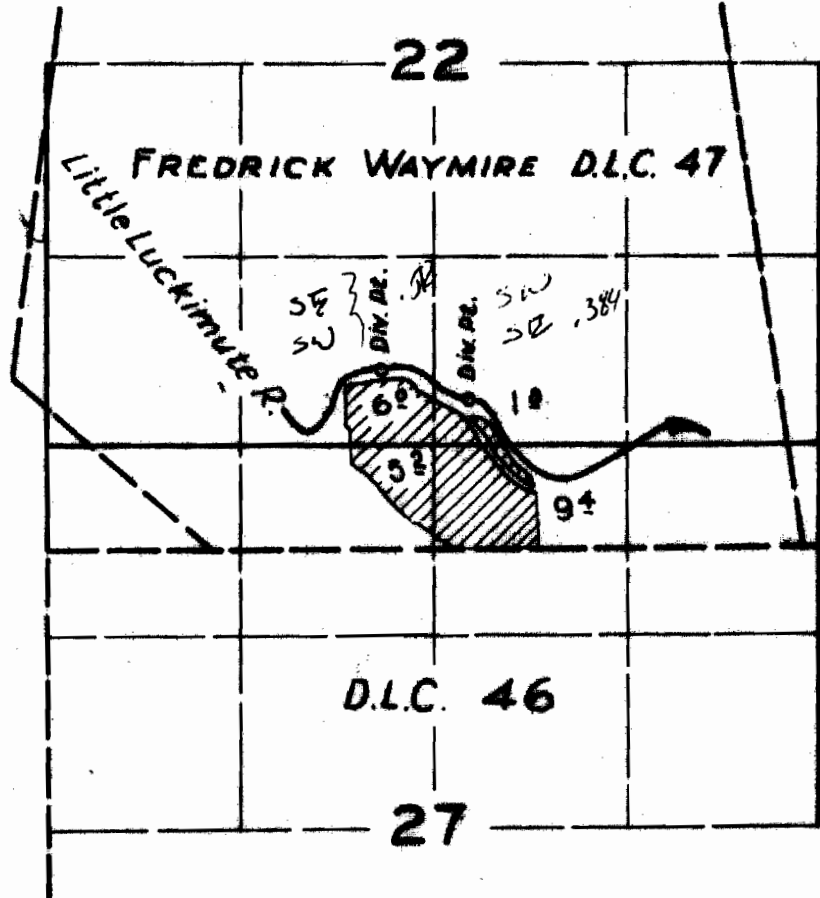

1.28 ACRES
CREP
LEASE

FINAL PROOF SURVEY
UNDER

Application No. 24680. Permit No. 19485
IN NAME OF

WM. J. & NELLIE E. COLGRAVE

Surveyed May 13, 1958, by R.H. Whitby.

27435

DFP-2P-47