

SECTION

\_\_\_\_\_


\_\_\_\_\_

\_\_\_\_\_

\_\_\_\_\_

TOWNSHIP 8S, RANGE 6W, W. M.

Tax lot  
1500  
2.11  
acres

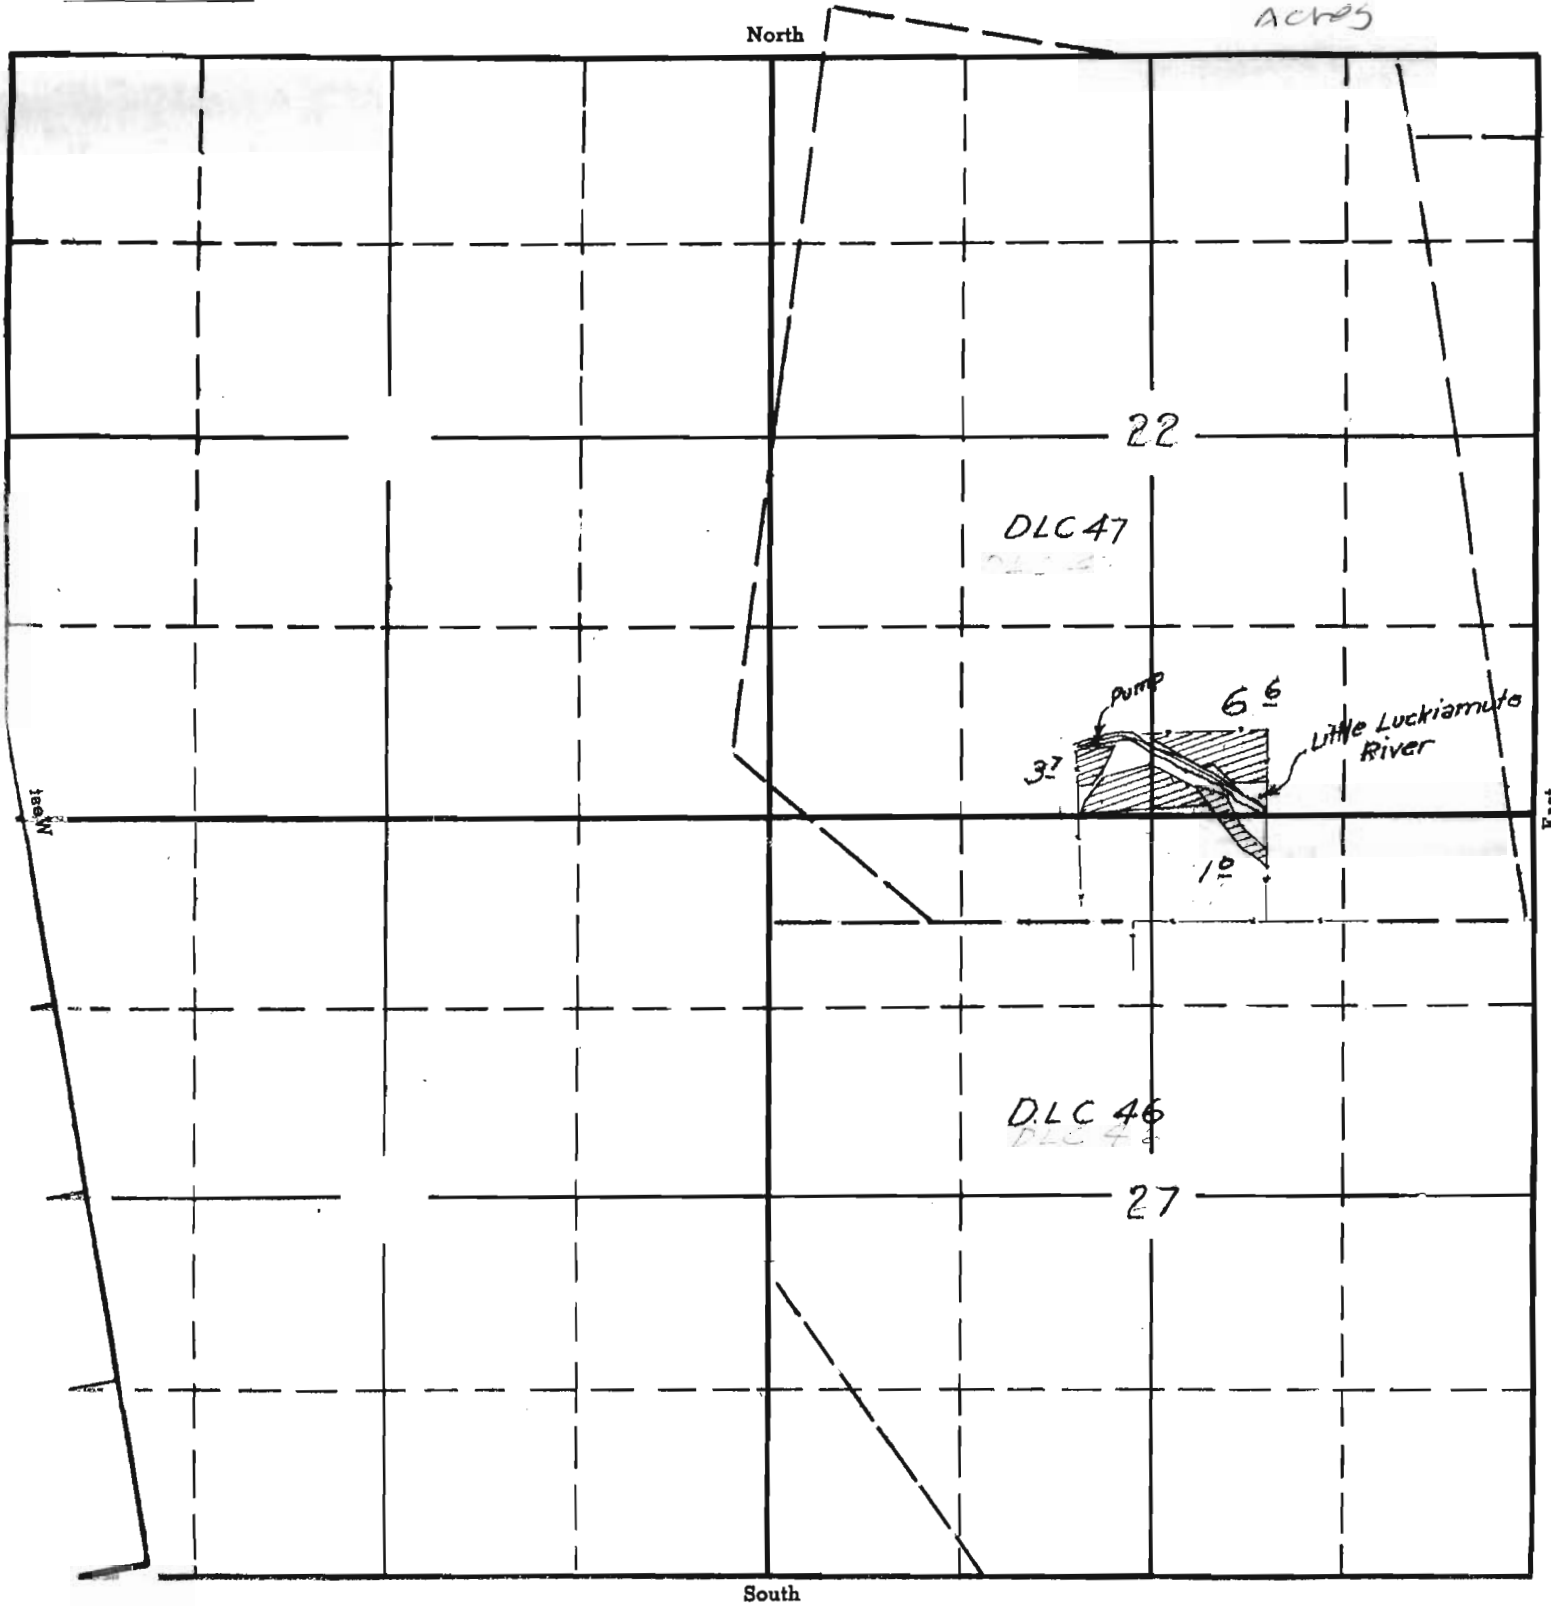

APPLICATION No. 15063  
PERMIT No. 10969

11898

*filed with proof*