

RECEIVED
MAY 15 2003
WATER RESOURCES DEPT.
SALEM, OREGON

Exhibit A: Tax lot map of Lessor's property

SE 1/4 SEC. 2J T14S. R. 10E. W.M. 1, 2, 3, 1000

14 10 21D



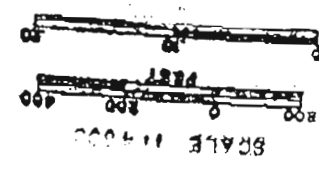


Exhibit B: Detailed map illustrating lands under subject rights to be leased


THIS MAP TO SERVE AS OFFICIAL "OFF" MAP.

POINT OF DIVERSION

SE 1/4, NW 1/4, SEC. 13, T14S, R9E, W.M.,
2350 FEET SOUTH AND 2150 EAST FROM
THE NW CORNER OF SECTION 13.

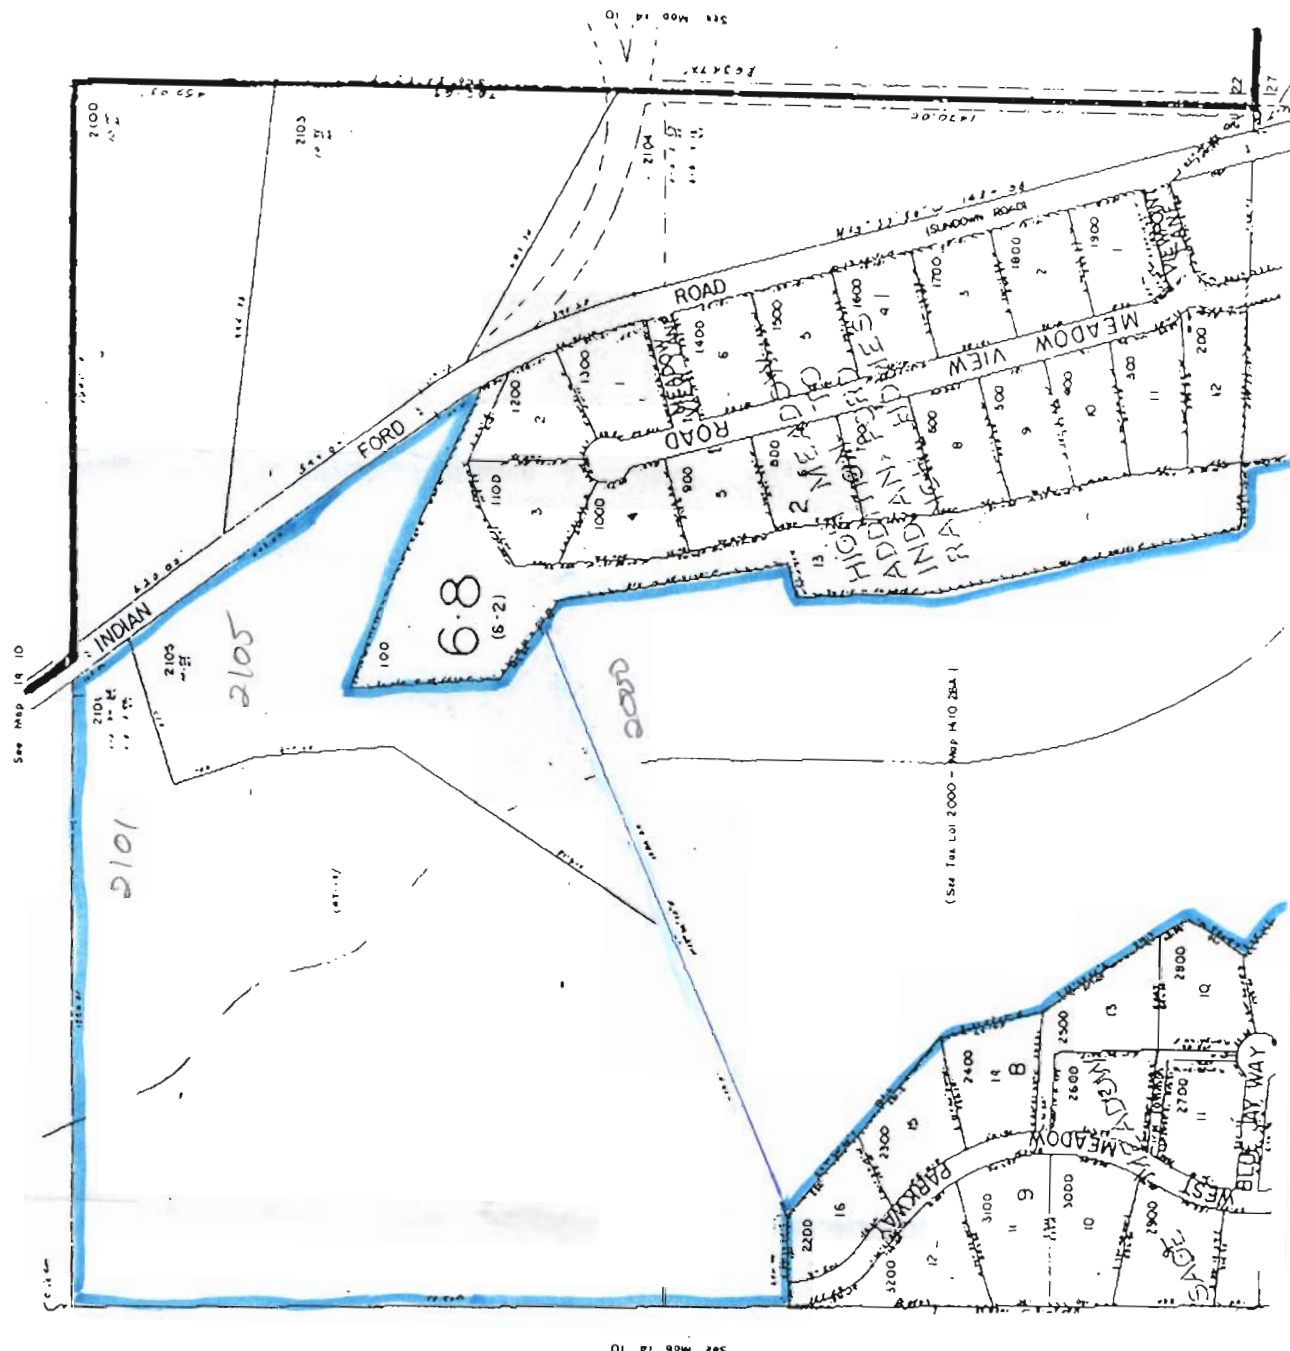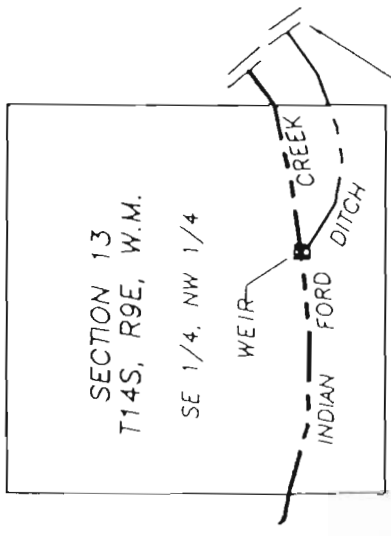

THIS MAP IS FOR THE PURPOSE OF IDENTIFYING THE LOCATION OF THE WATER RIGHT.
IT IS NOT INTENDED TO PROVIDE LEGAL DIMENSIONS OR LOCATIONS OF PROPERTY
OWNERSHIP LINES.

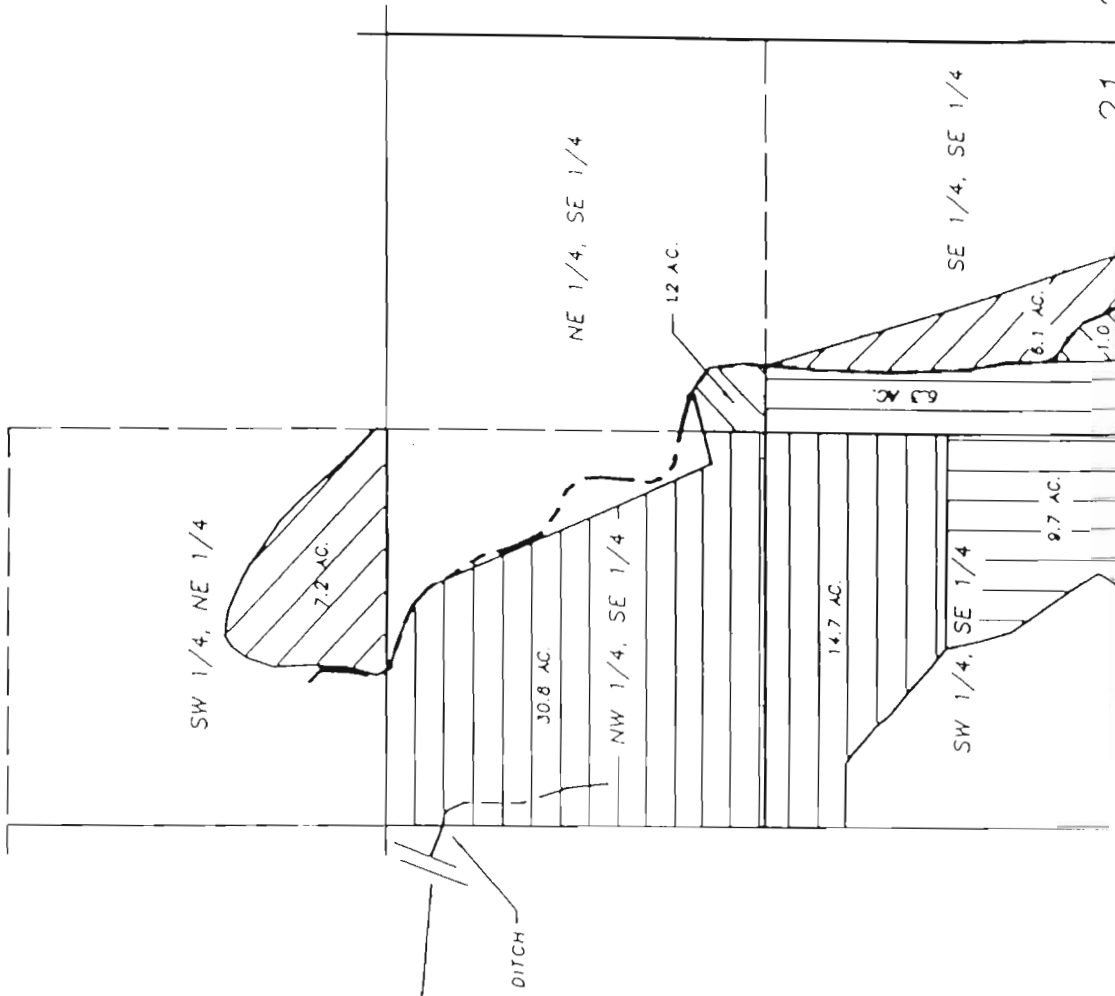


THE DISTANCE ALONG THE
DITCH FROM POINT OF
DIVERSION TO PLACE OF
USE IS 3.8 MILES.

LEGEND

- "1871" CERT. # 14782
0.91 CFS - 45.5 AC.
- "1882" CERT. # 274
0.46 CFS - 20.0 AC
- "1903" CERT. # 14782
0.11 CFS - 5.5 AC


"1903"
 0.61 CFS - 20.5 AC
 "1905"
 0.82 CFS - 18.4 AC

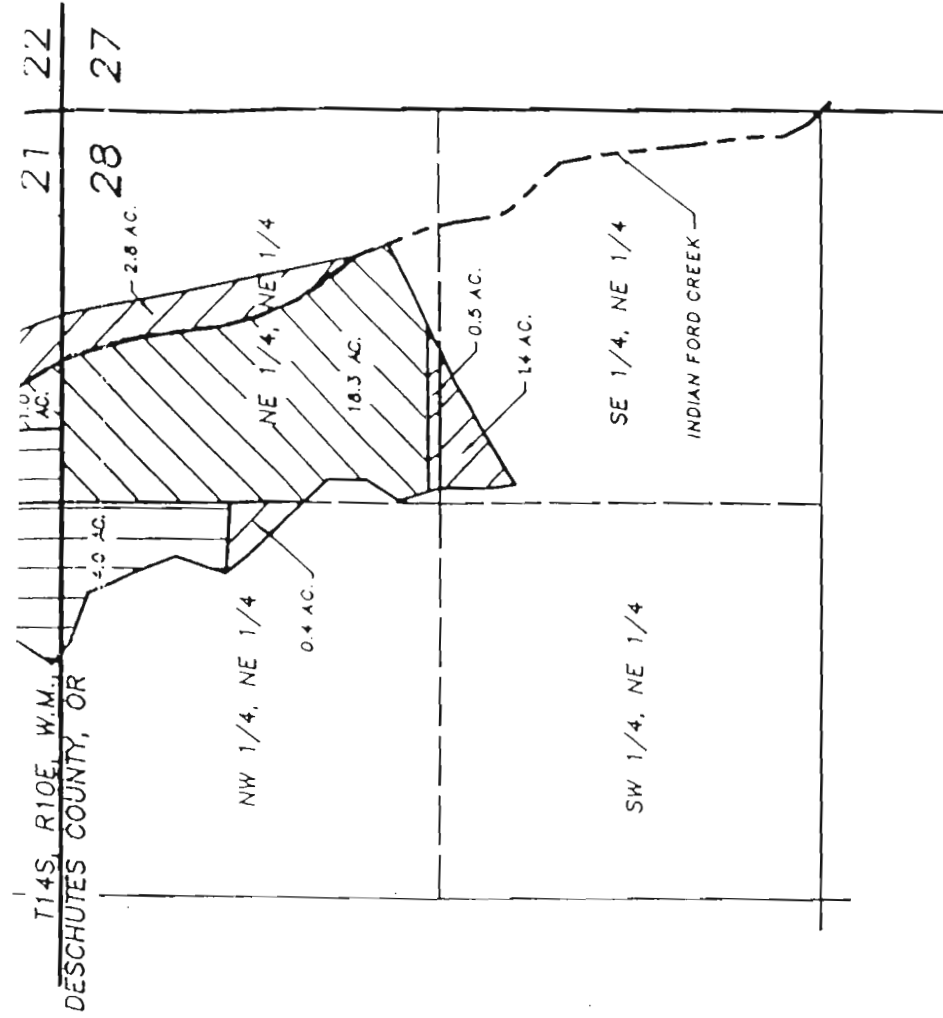

9.22-99


FINAL PROOF SURVEY
 THE WILLOWS RANCH
 WATER RIGHTS TRANSFER
 T-6615

JAMES AND JUDITH KNAPP

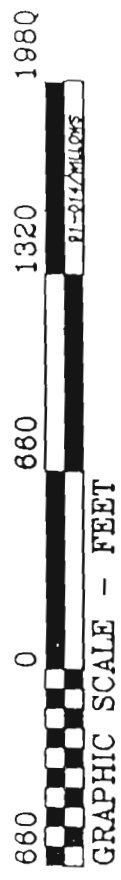

WATER RIGHT TRANSFER APPLICATION MAP

POINT OF DIVERSION
SE 1/4, NW 1/4, SEC. 13, T14S, R9E, W1M,
2,150 FEET SOUTH AND 2150 EAST FROM
THE NW CORNER OF SECTION 13.

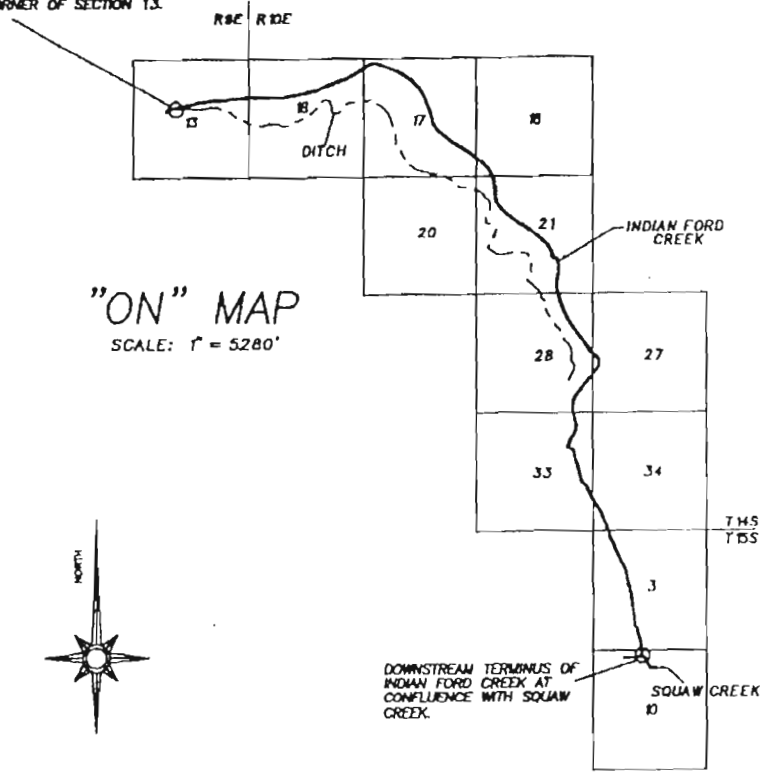

"ON" MAP
SCALE: 1" = 5280'

PROPOSED PLACE OF USE
INDIAN FORD CREEK (IN STREAM) BELOW
RIVER MILE 8 TO MOUTH OF INDIAN
FORD CREEK AT SQUAW CREEK.

APPLICANT
OREGON WATER TRUST
111 NAITO PARKWAY
SUITE 404
PORTLAND, OREGON 97204

