

MAP

SEE MAP


PARTITION PLAT NO. 1994-82

4-02

PARCEL 3

23C

26 6 23D

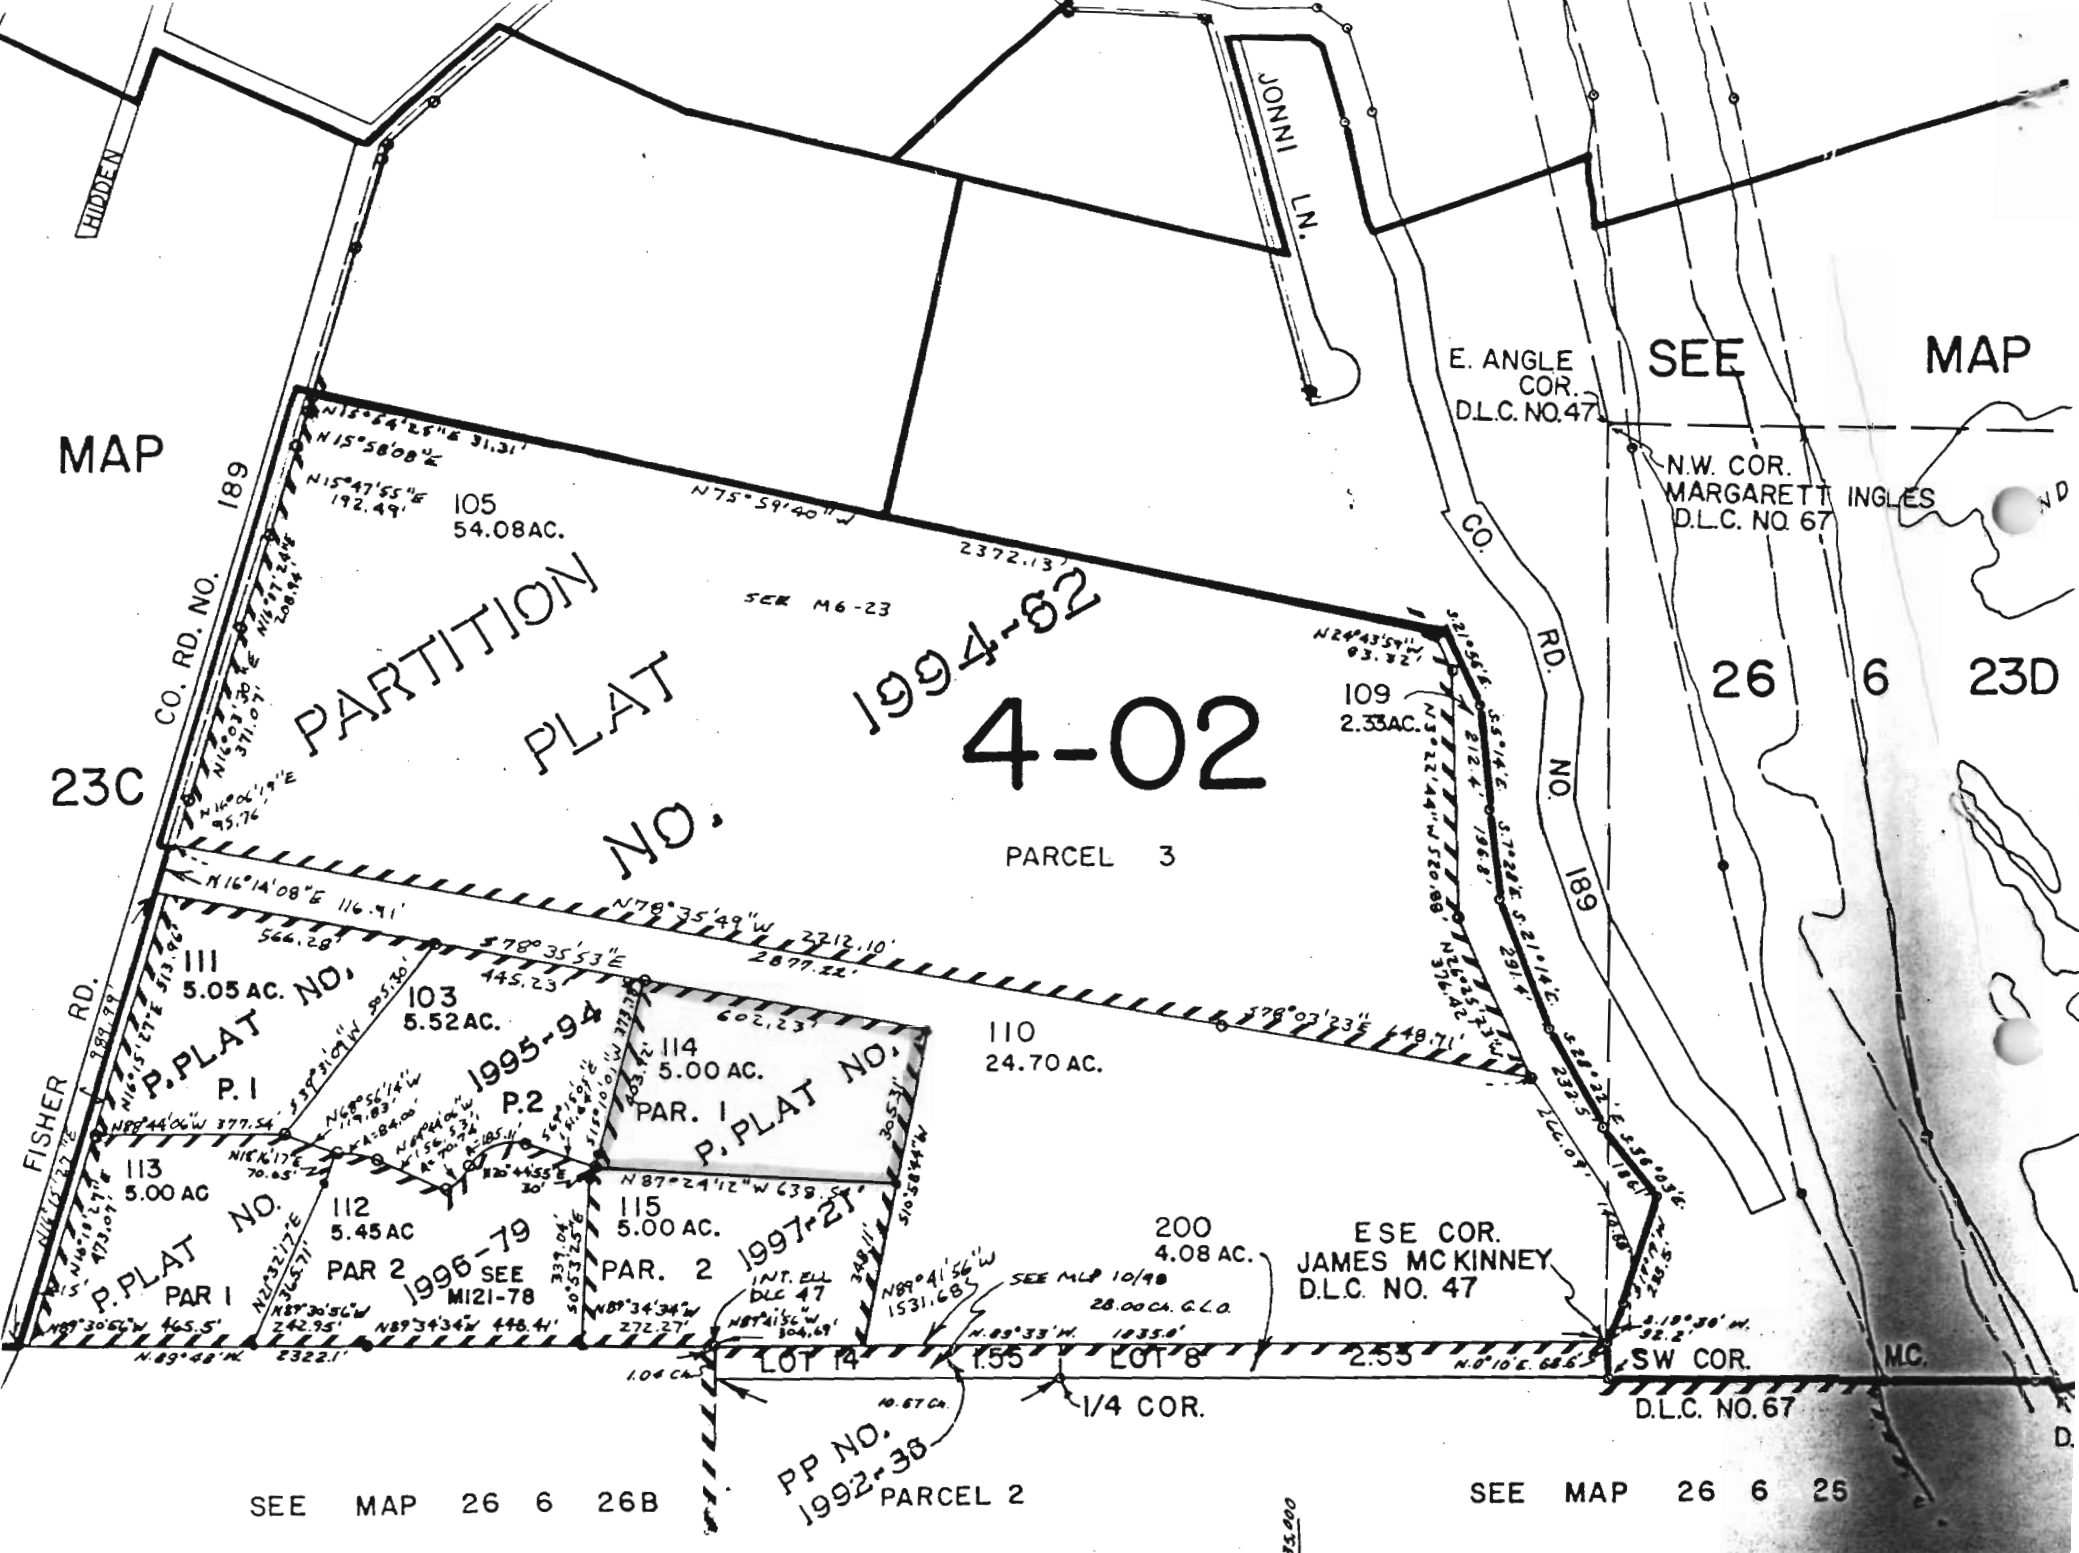

E. ANGLE COR. D.L.C. NO. 47

N.W. COR. MARGARETT INGLES D.L.C. NO. 67

109 2.33AC.

110 24.70 AC.

ESE COR. JAMES MCKINNEY D.L.C. NO. 47

SW COR. D.L.C. NO. 67


PP NO. 1992-38 PARCEL 2

SEE MAP 26 6 26B

SEE MAP 26 6 25

D.

# T.26S. R.6W. W.M.

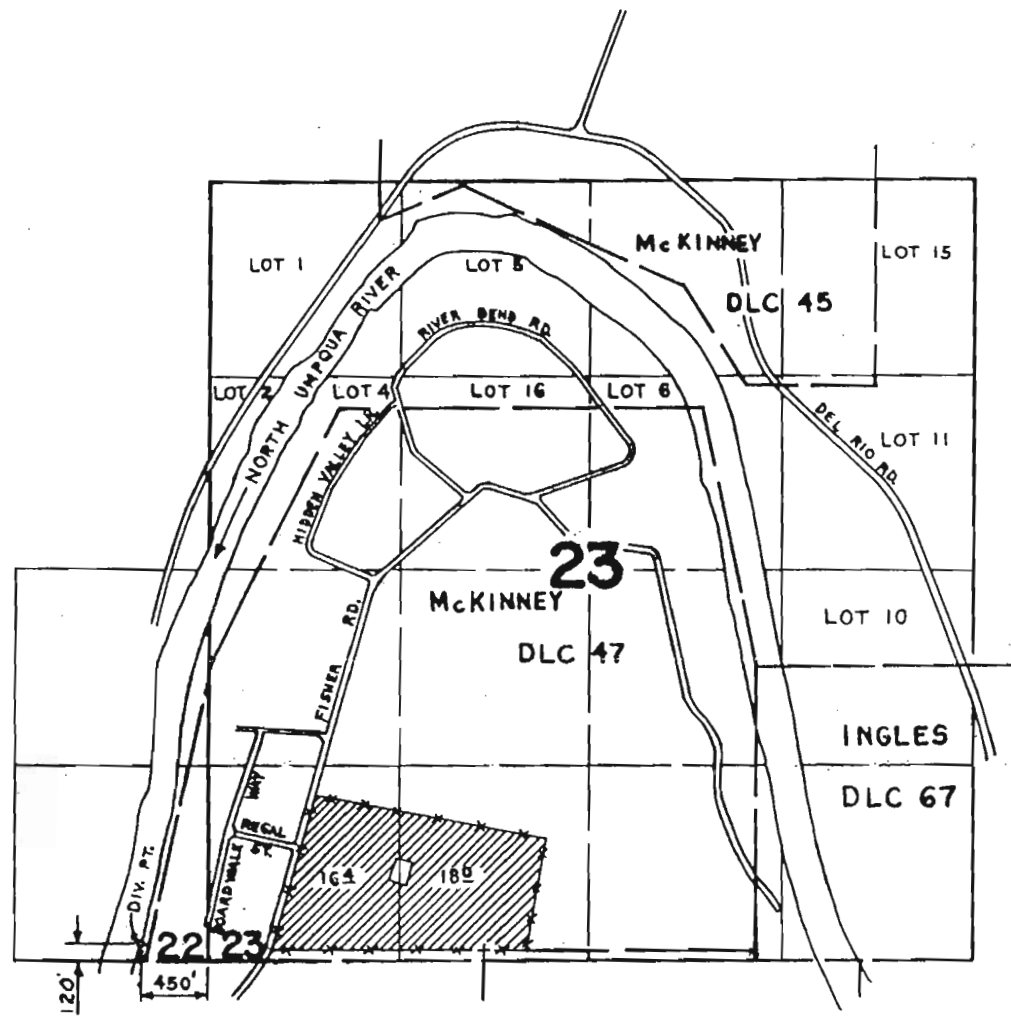

SCALE: 4" = 1 mile

## FINAL PROOF SURVEY UNDER

Application No. 63422.. Permit No. 46773.....  
IN NAME OF

JOE G. MACHADO JR......

Surveyed DEC...9... 1983, by L...CASHION....