


T.29S. R.4W. W.M.

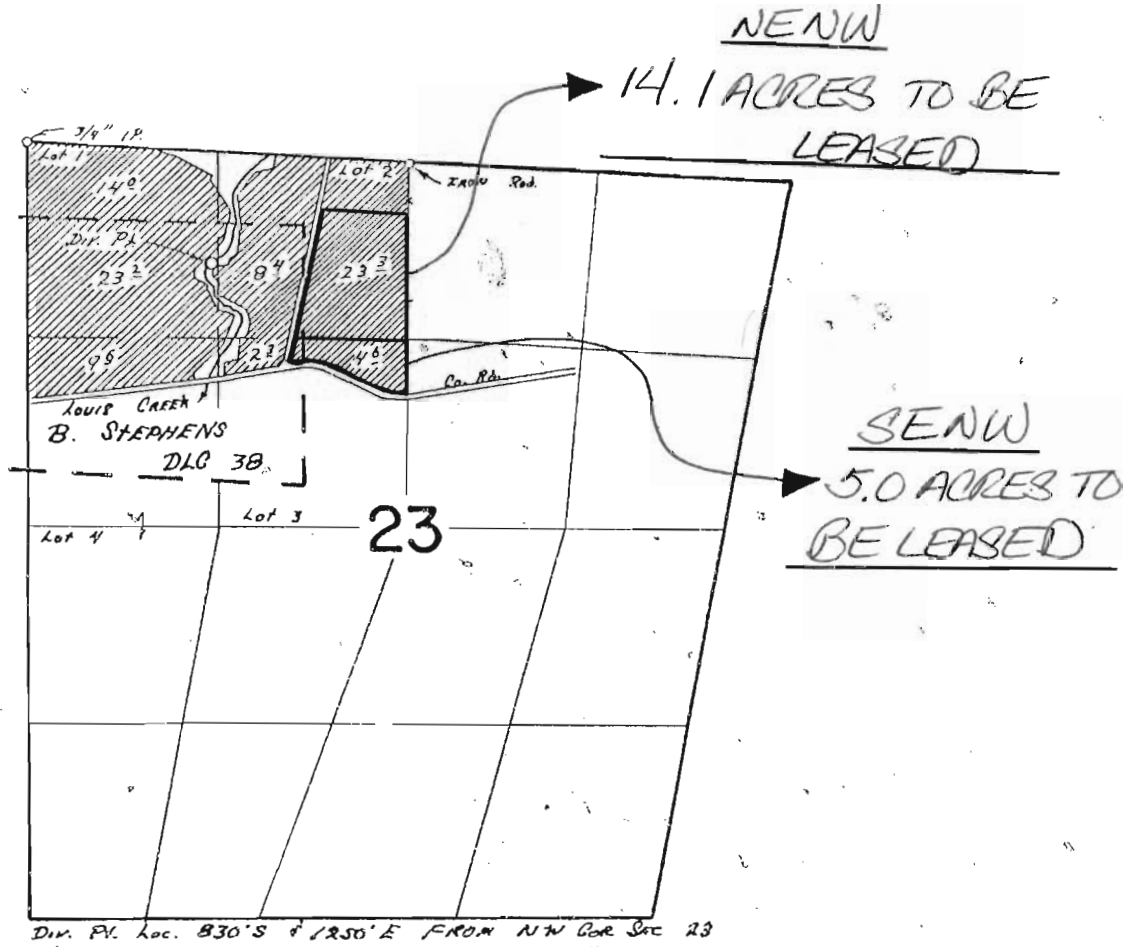

FINAL PROOF SURVEY  
UNDER

TRANSFER No. M-123  
Application No. \_\_\_\_\_ Permit No. 6647  
IN NAME OF

MRS. F. A. MOAN

Surveyed Oct. 14, 1966, by V. BARNER

SEC. 23 T.29S. R.4 W. W.M.  
DOUGLAS COUNTY

REVISED ON  
1-23-93

29 4 23

THIS MAP WAS PREPARED FOR  
ASSESSMENT PURPOSE ONLY

1"=400'



PARCELS NO'S  
2301 2401 2402  
2501

PARCEL 2 609 S. 2700

507.550'

4,217,000

SEE MAP 29 4 26

29 4 23