


T.15S.,R.46E.,W.M.

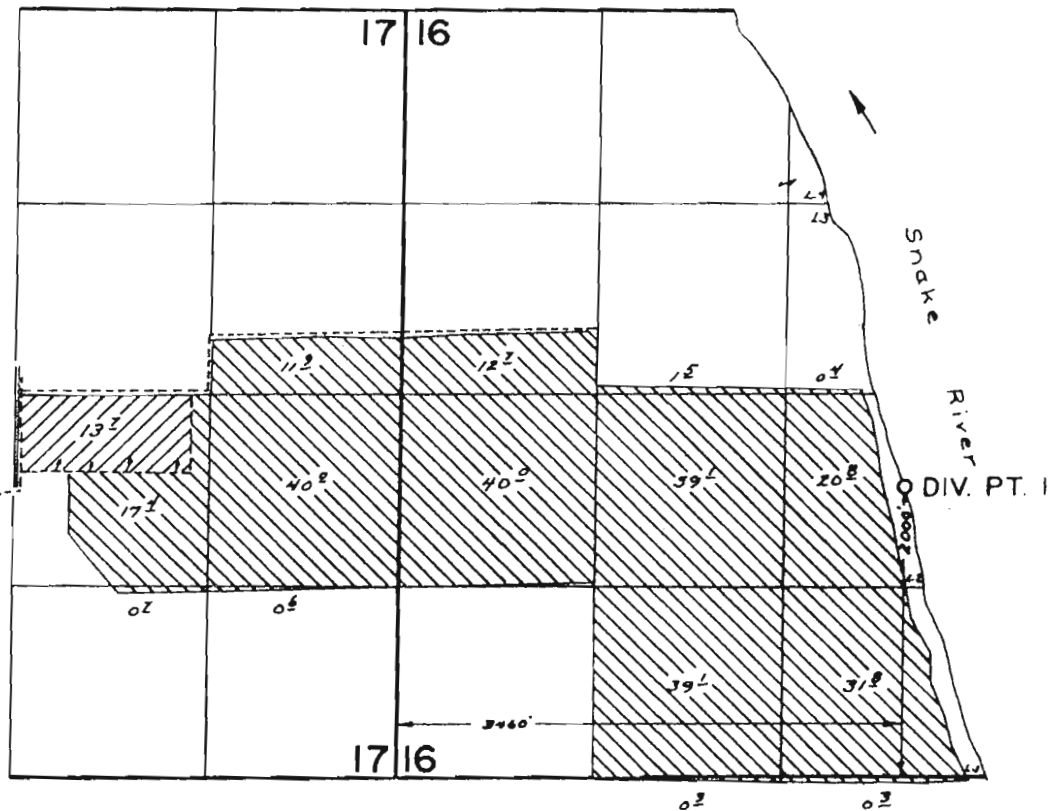

SEC. 17
L.2(SWNW)

DIV. PT. 2

Loc: 1020 ft S and 2450 ft W.
from the SE Cor NE 1/4 NW 1/4 Sec. 17

FINAL PROOF SURVEY
UNDER

Application No. 56056. Permit No. 41976.....

IN NAME OF




OASIS ACRES, AND



PAUL S. AND JOYCE FRIEDRICHSEN

Surveyed AUG. 31. 1981., by L. TOLL.....

T.15 S. R. 46 E. W.M.

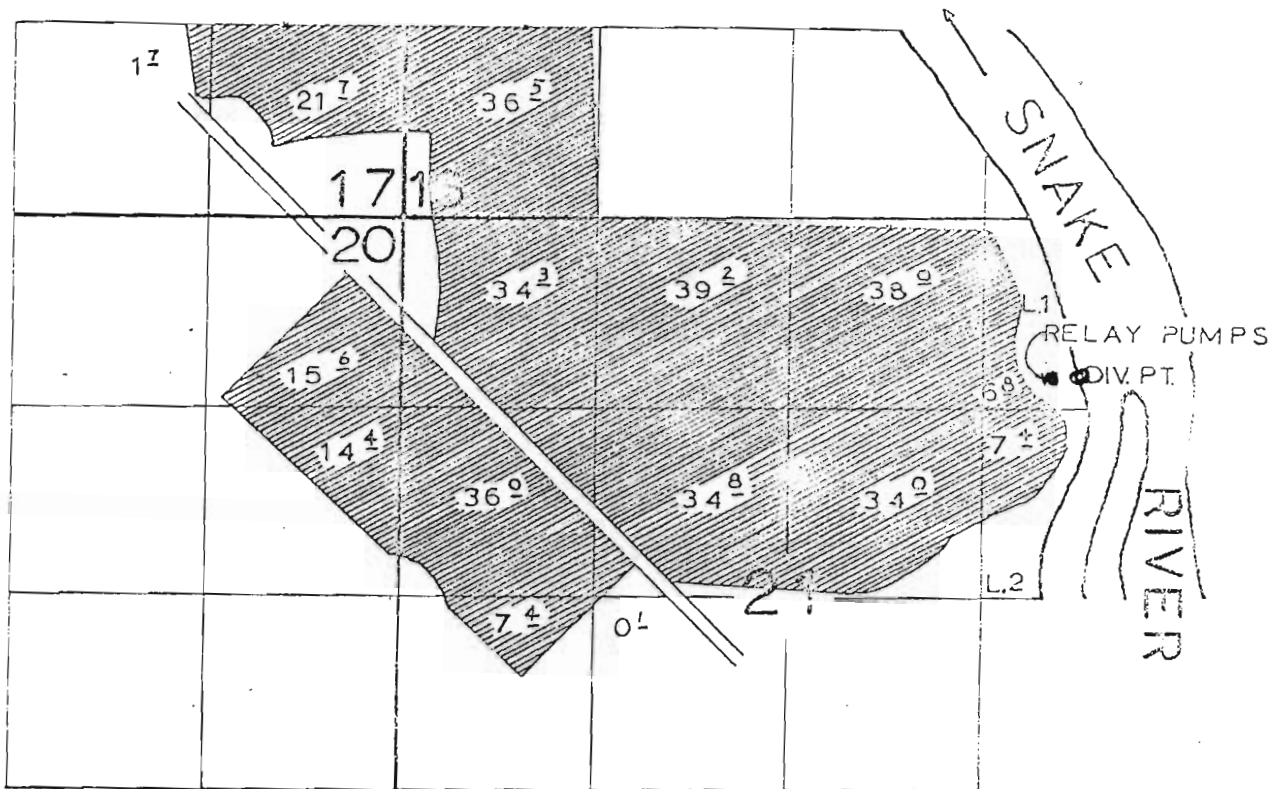

DIV. PT. IS 1100' S. & 458' E. FROM NW COR. SEC. 21

FINAL PROOF SURVEY UNDER

Application No. 41851... Permit No. 31319...
IN NAME OF

THEODORE N. BOKIDES

Surveyed SEPT. 18 1970, by ELFERING