


T. 29S, R. 4W.WM.

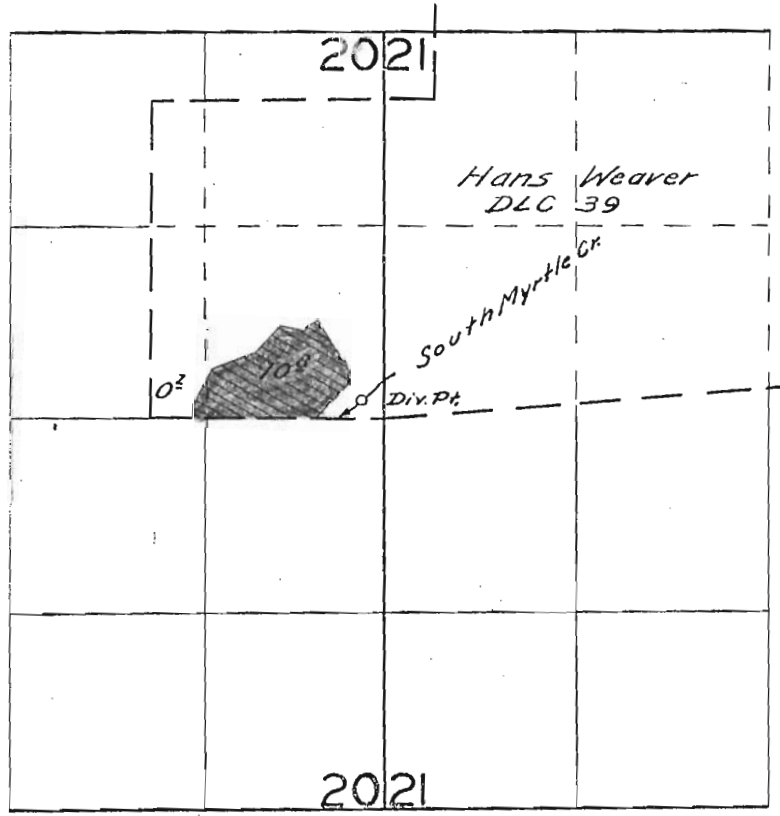

FINAL PROOF SURVEY
 UNDER

Application No. 25891 Permit No. 20318
 IN NAME OF

Frank L. Radford

Surveyed Aug. 31 1956, by G.O. Bartels