
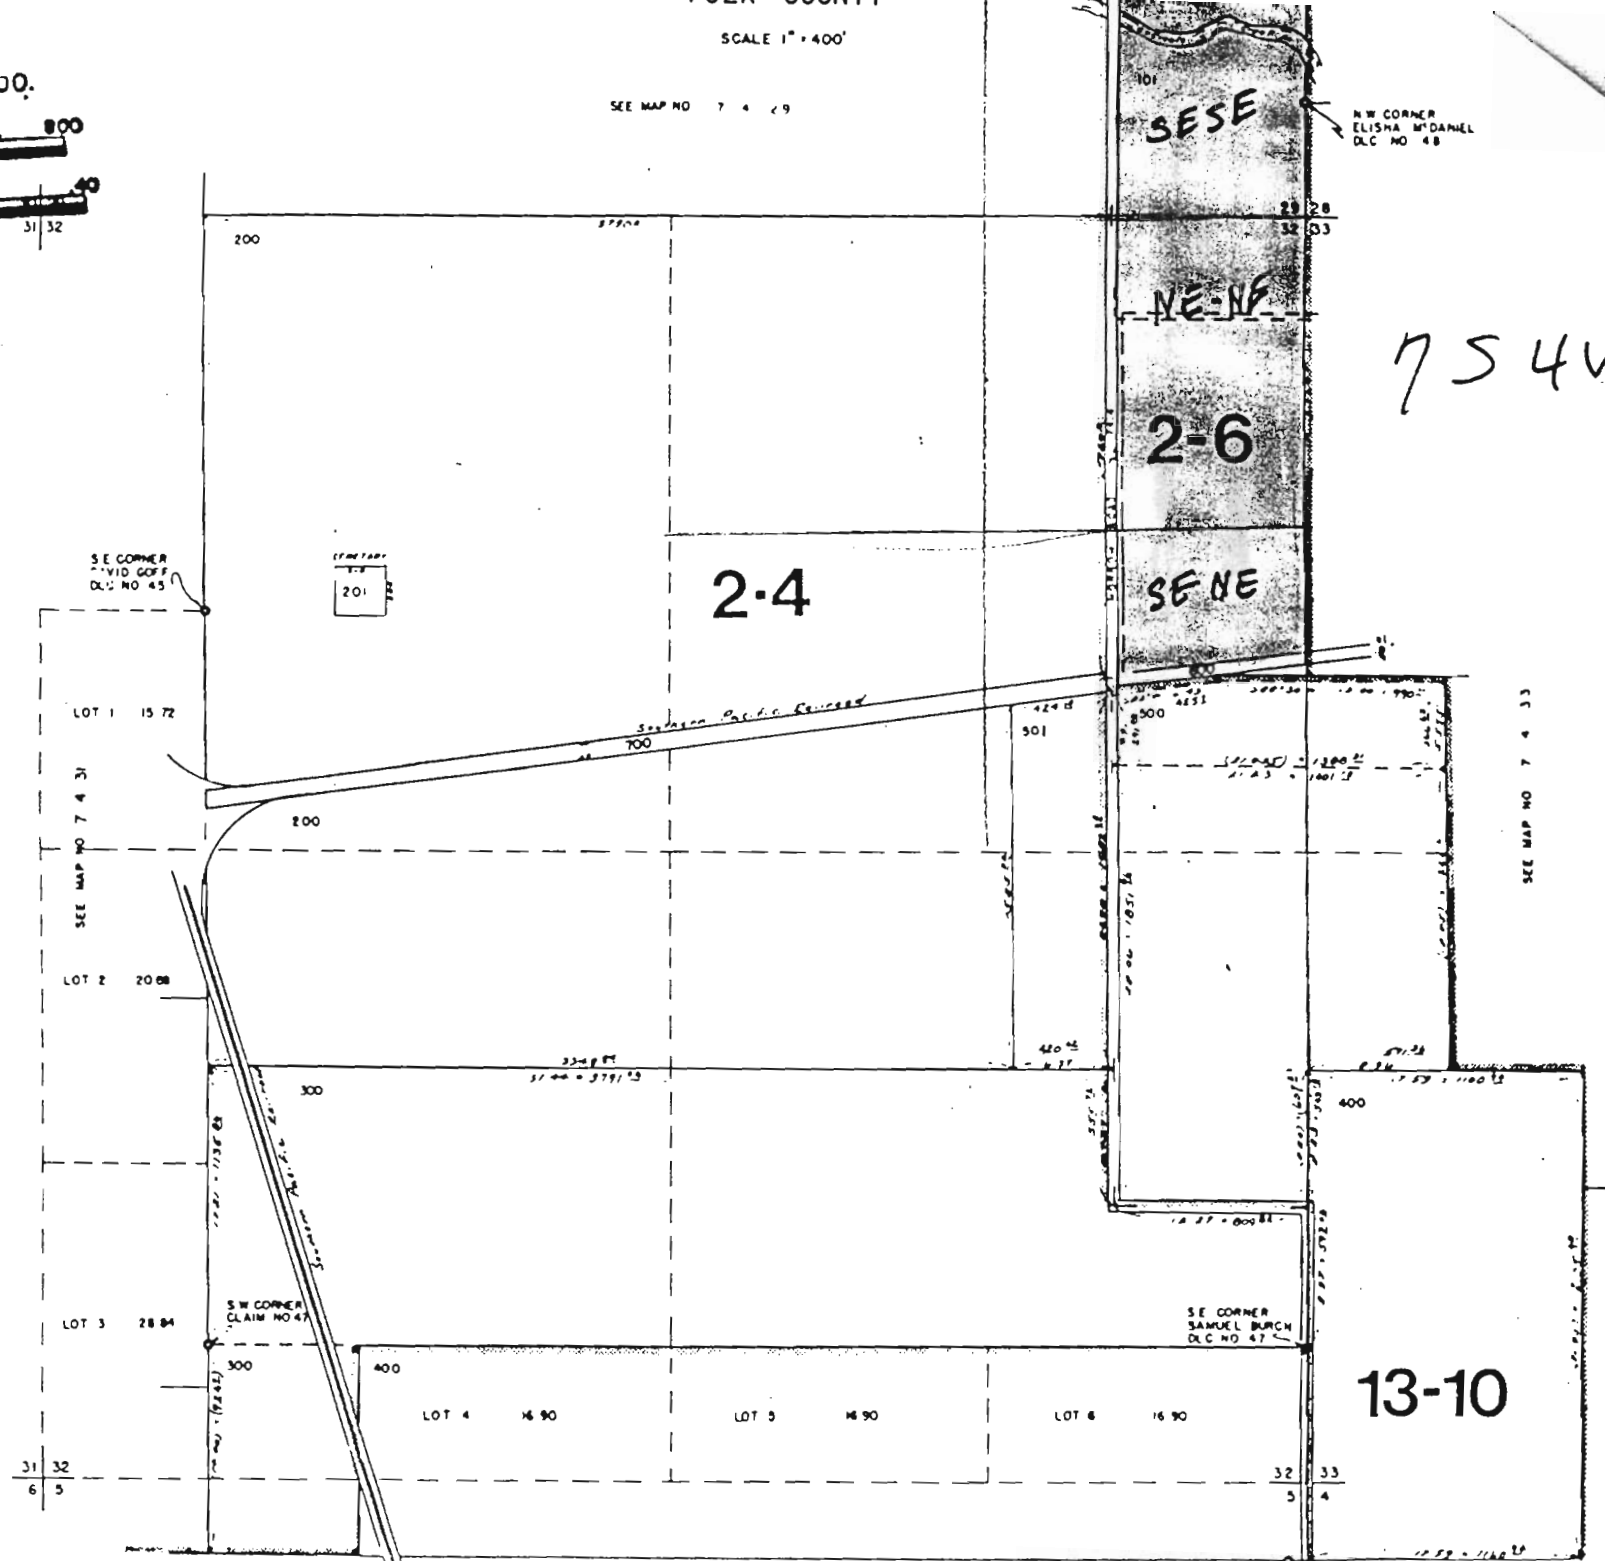


SCALE 1:6600.

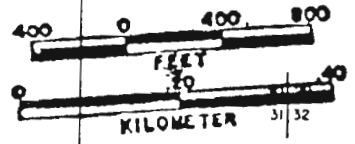

754W

SEE MAP NO 7 4 33

13-10