


T.5S.R.5W.W.M.

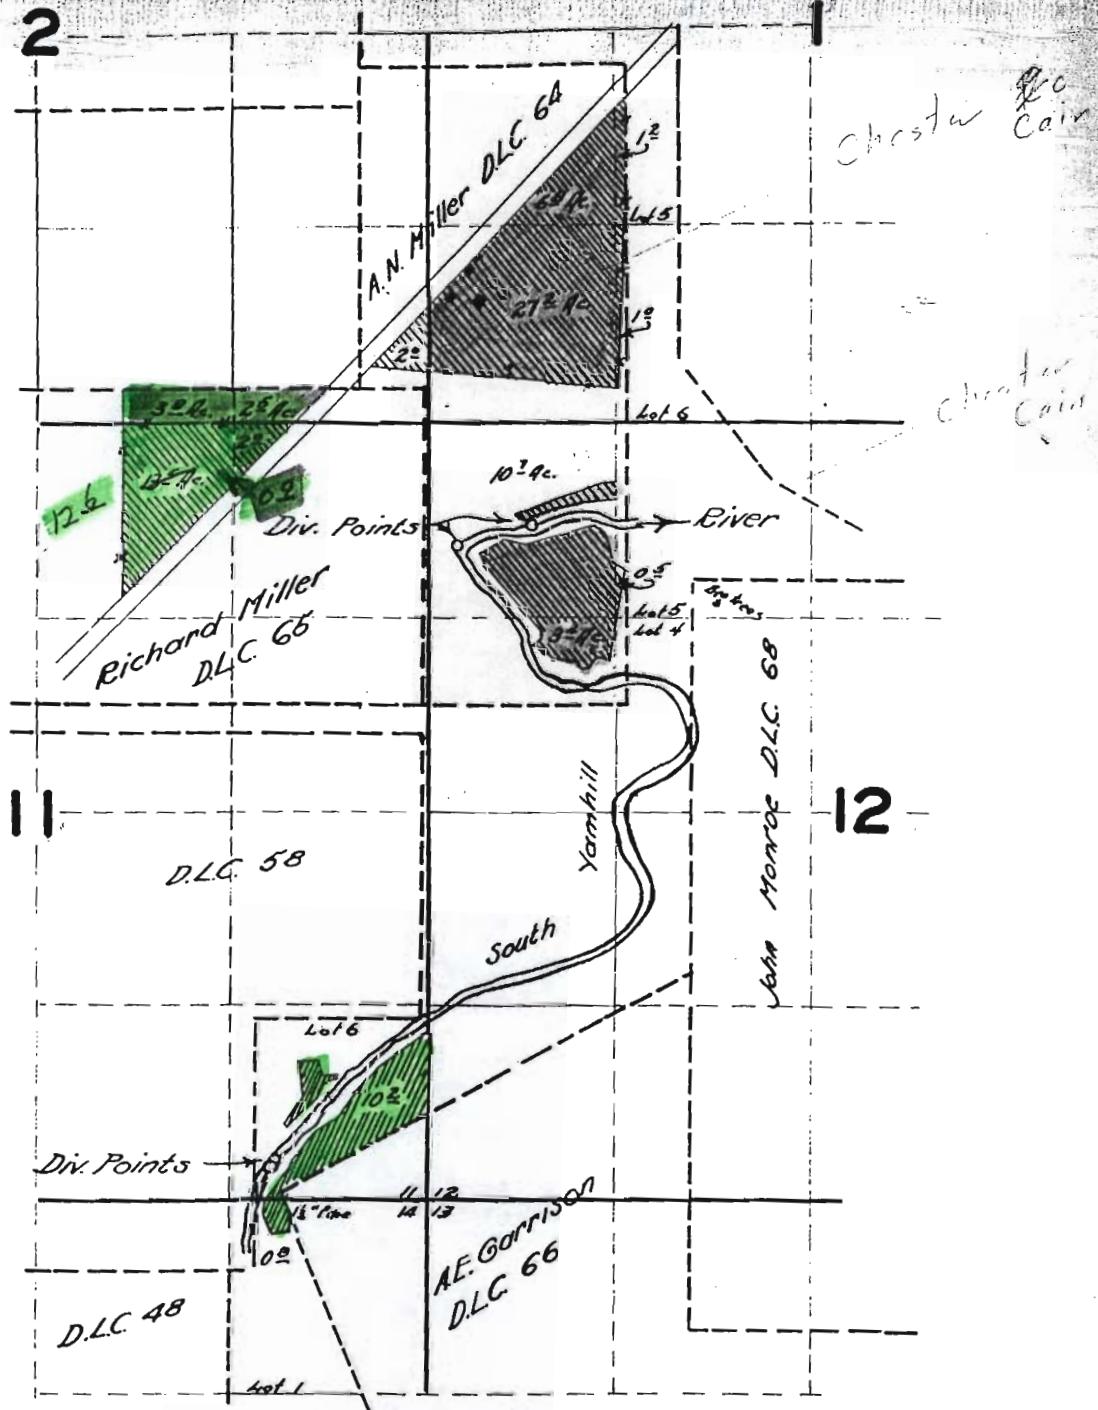

FINAL PROOF SURVEY

UNDER

17643

13340

Application No 23025 Part No 18196

IN NAME OF

CHESTER L. MULKEY


Surveyed 9/17 1951 by H.L. COFFMAN



19936

19870

T.5S.R.5W.W.M.

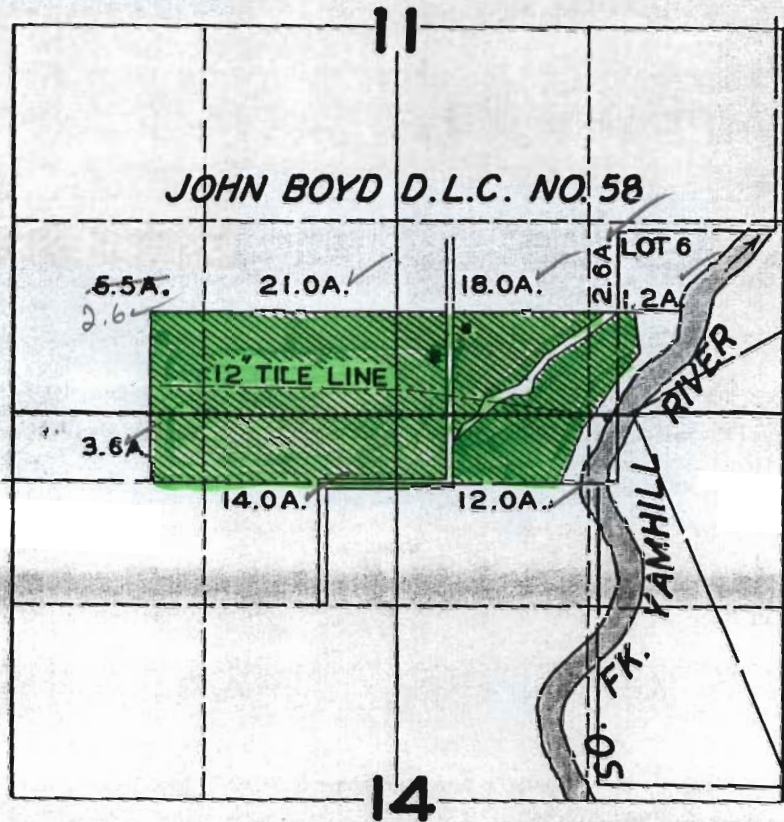

FINAL PROOF SURVEY
UNDER

Application No. **19989** Permit No. **15553**
IN NAME OF

CHESTER L. MULKEY

Surveyed **JUNE 9, 1948**, by **JAS. E. BUNNELL**