


T. 6S. R. 8W. W.M.

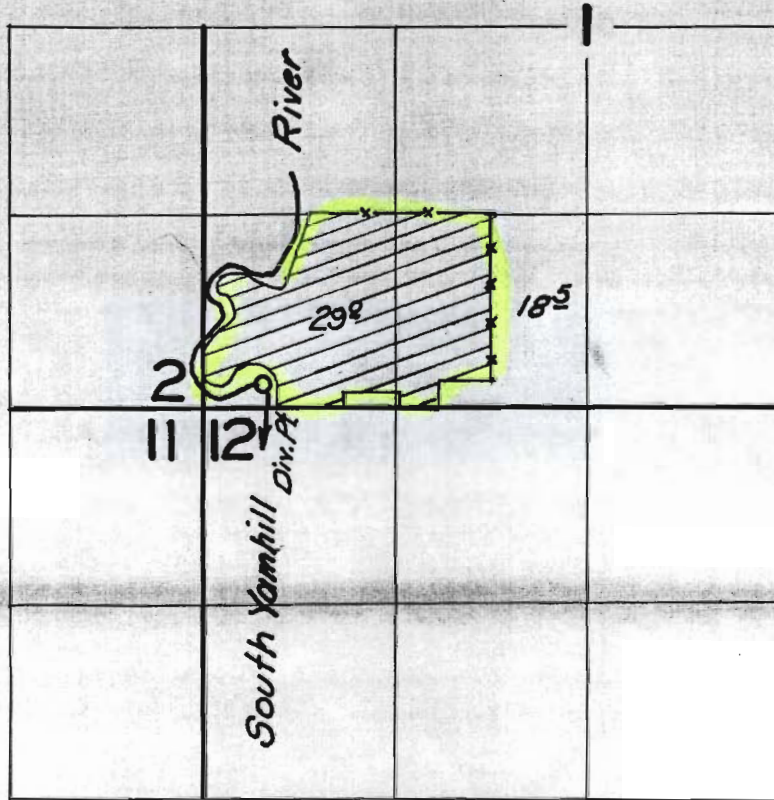

**FINAL PROOF SURVEY**  
UNDER

Application No. 32944 Permit No. 26036  
IN NAME OF

.....Lester Mahurin.....

Surveyed 21 June 1962, by Carl R. Baker.