


T.4 S.R.4 W.W.M.

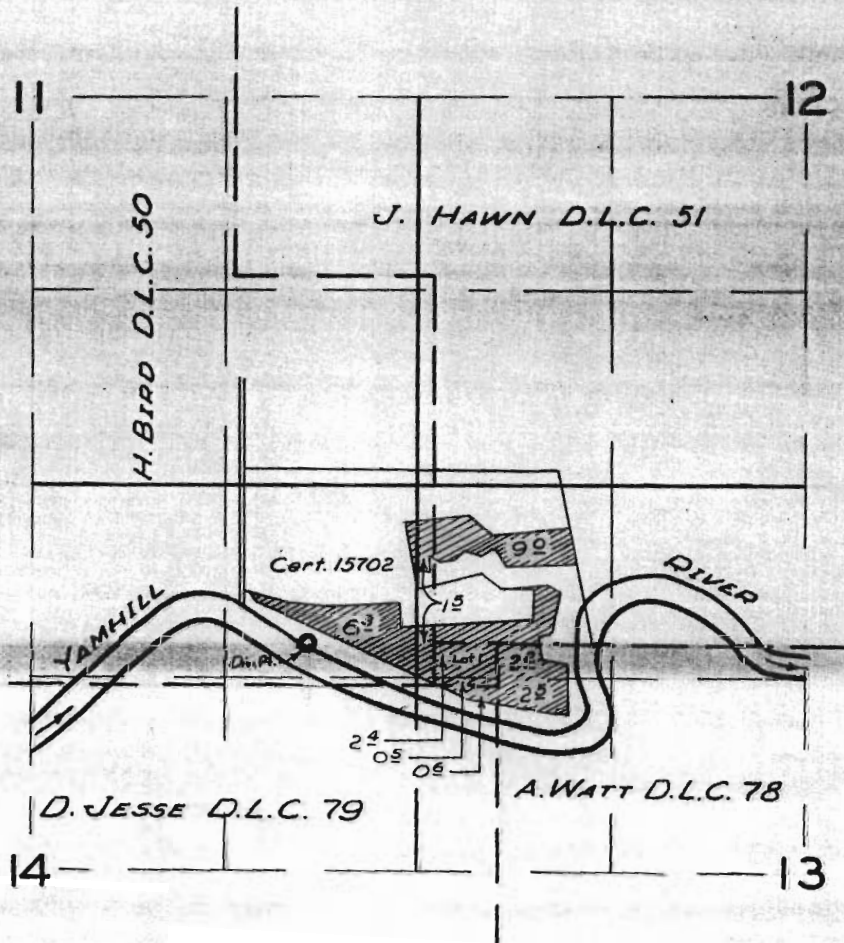

Lands Leased

**FINAL PROOF SURVEY**  
UNDER

Application No. 32168 Permit No. 25379  
IN NAME OF

STANLEY MALOTT

Surveyed 27 MAY 1960 by M. Bick