


T.9S. R.4W. W.M.

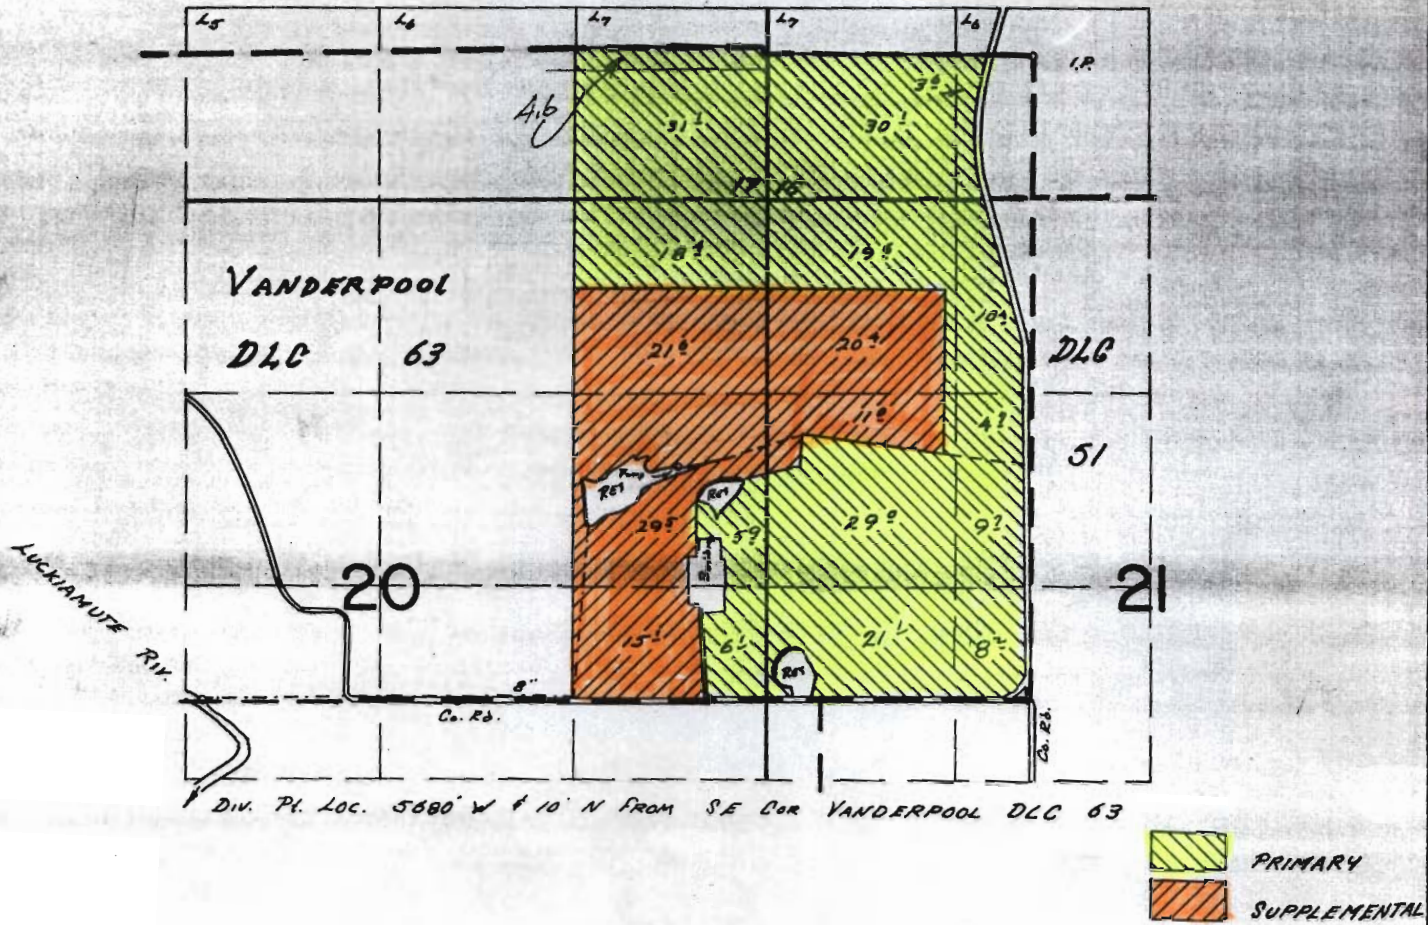

**FINAL PROOF SURVEY**  
UNDER

Application No. 48318 Permit No. 35334  
IN NAME OF

PATRICK A. OGLE

Surveyed MAY 13 1974 by T. J. Paul