


30334 6

T. 7 S. R. 19 E. W. M.

EXHIBIT D

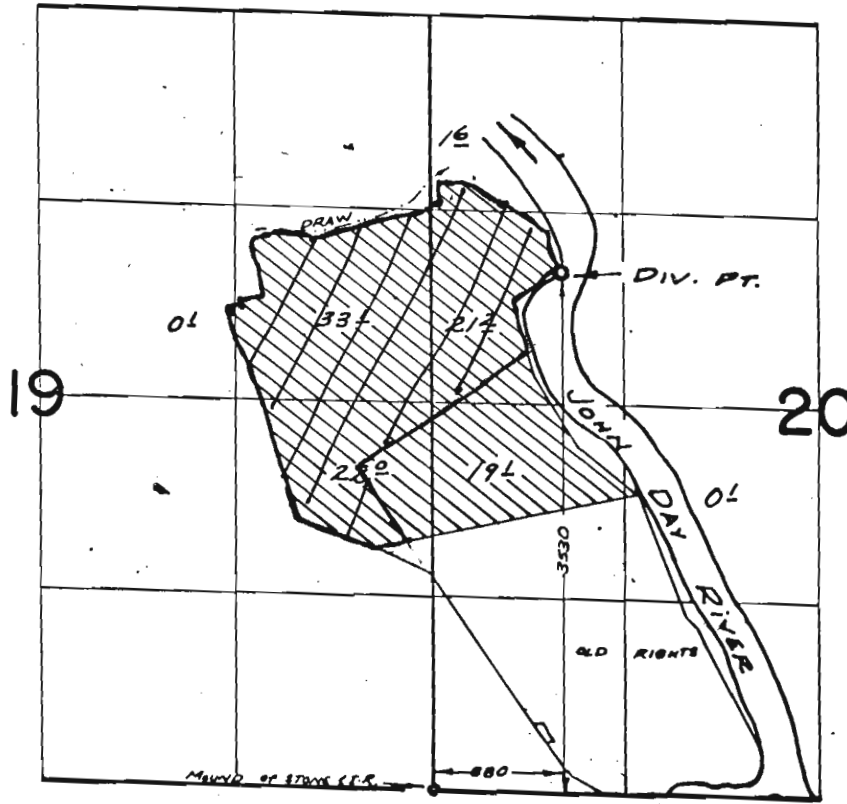

1997 lease

FINAL PROOF SURVEY  
UNDER

Application No. 40724 Permit No. 30334  
IN NAME OF

RODNEY P. ROLFE

Surveyed Nov. 21, 1971, by R. MUCKEN