


T. 7 S. R. 19 E. W. M.

EXHIBIT D

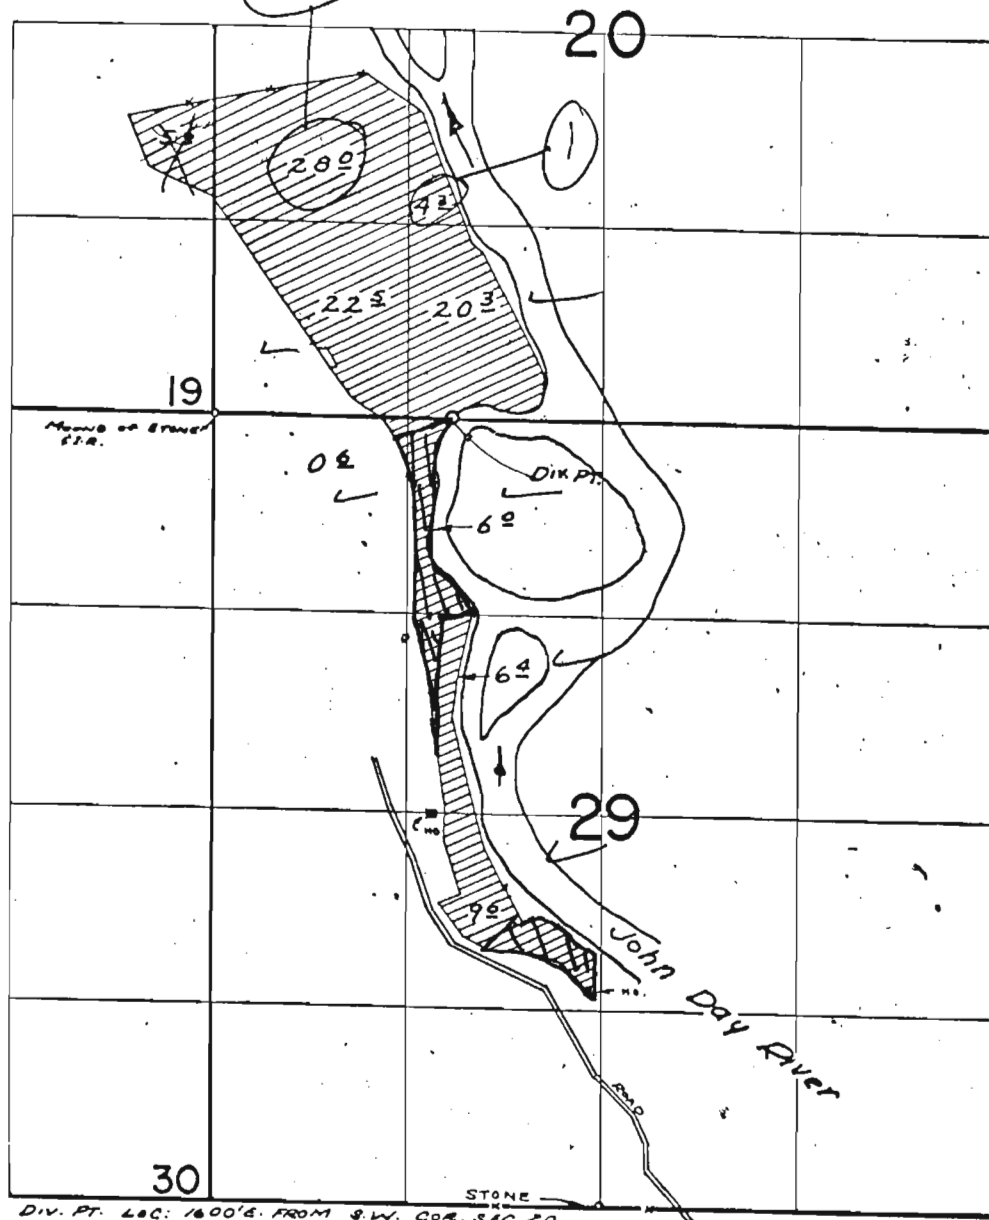

DIV. PT. L&C: 1600' E. FROM S.W. COR. SEC. 20

FINAL PROOF SURVEY  
UNDER

Application No. 22244 Permit No. 17507  
IN NAME OF

MARTIN W. NILL

Surveyed JUNE 17 1954, by H. L. GREENMAN

New Proof Map  
USE THIS ONE