

M-3382
RECEIVED


JUL 26 1995

T. 39 S., R. 8 W., W.M.

WATER RESOUR.
SALEM, OREGON
RECEIVED

DEC 30 1983

WM. DIST. 14
GRANTS PASS, ORE

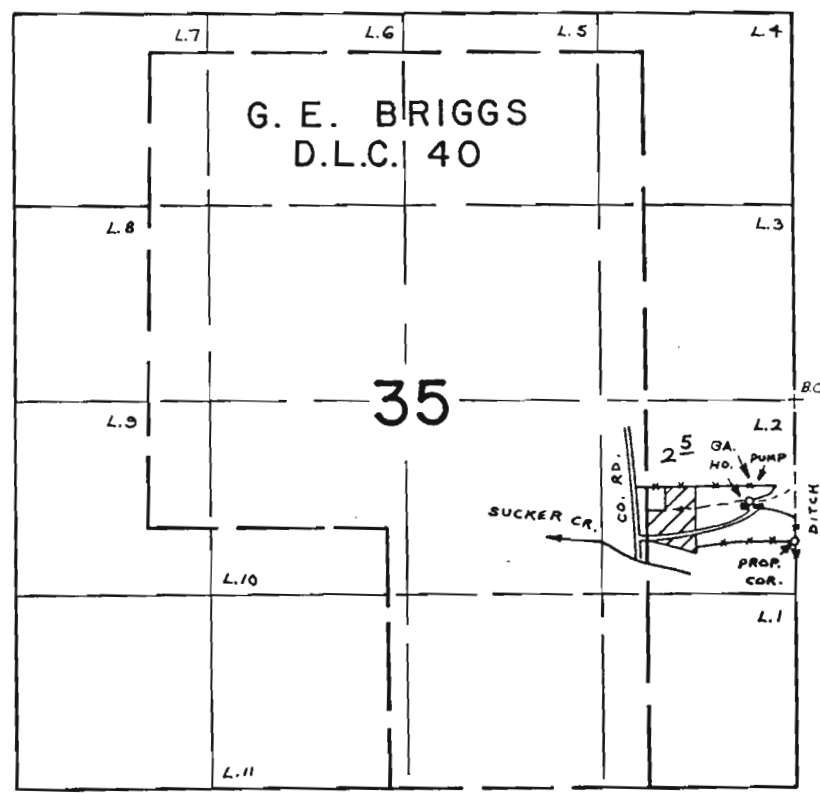

DIV. PT.: 2500' N & 300' E FROM 5/4 COR. SEC. 31. (BRIGGS - TANNERY DITCH)
T39S, R8W WM

FINAL PROOF SURVEY
UNDER

Transfer No. 3382
Application No. Permit No.
IN NAME OF

LOUIS N. & WILDA C. MAURER

Surveyed AUG. 3 1978, by B. SUND

D.H.M.
P.T.S. - 1978 - 14 - C

TL 100

TL 300

TL 501

TL 502

RECEIVED
JUL 20 1995
WATER RESOURCES
SALEM, OREGON

