


Exhibit B

PARTITION PLAT NO. 1994

See Map II

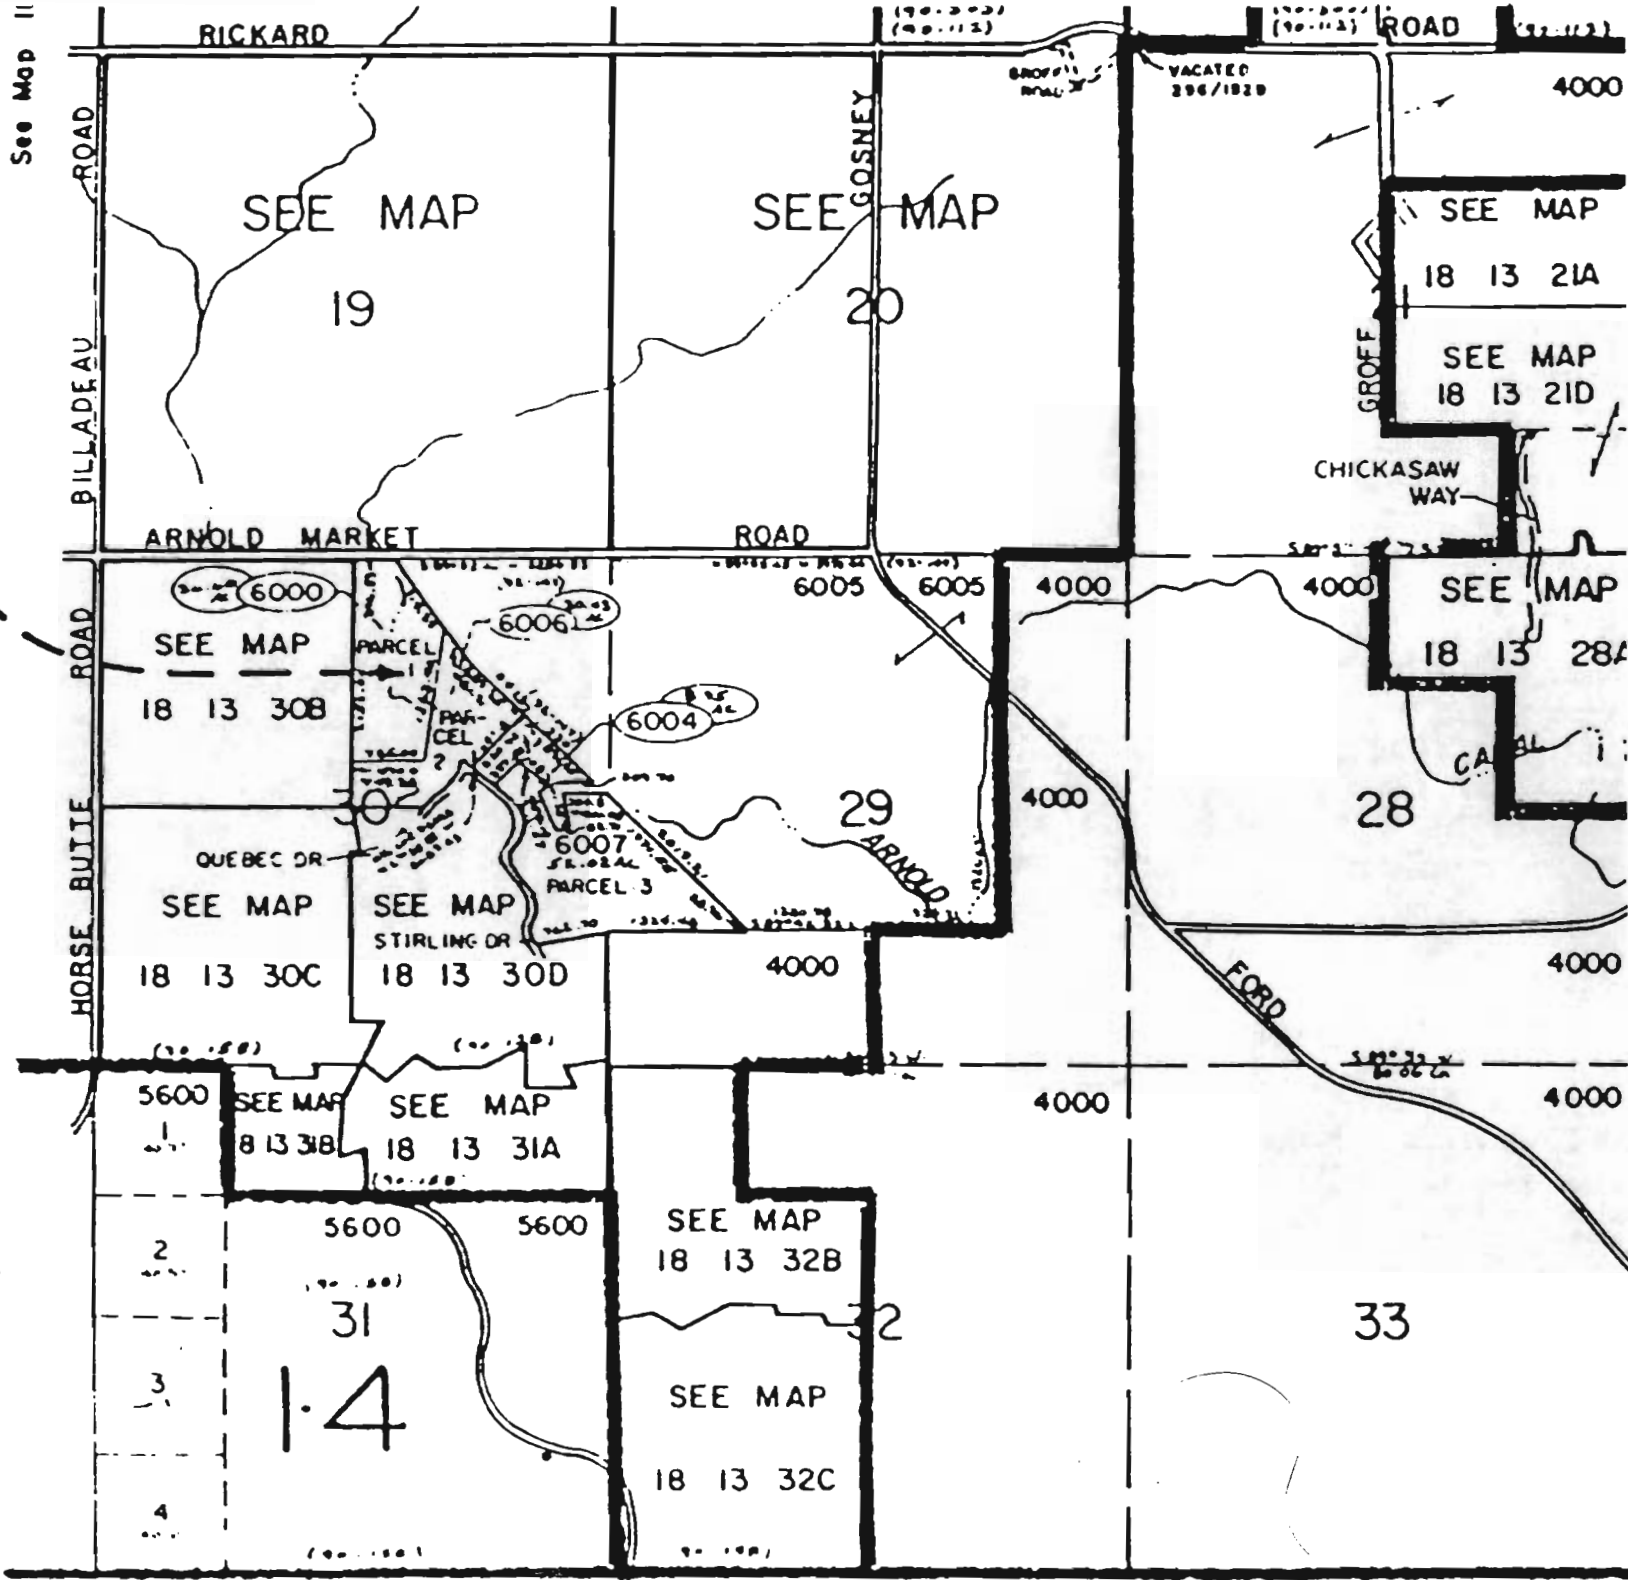

MAY 1 1996

1.4


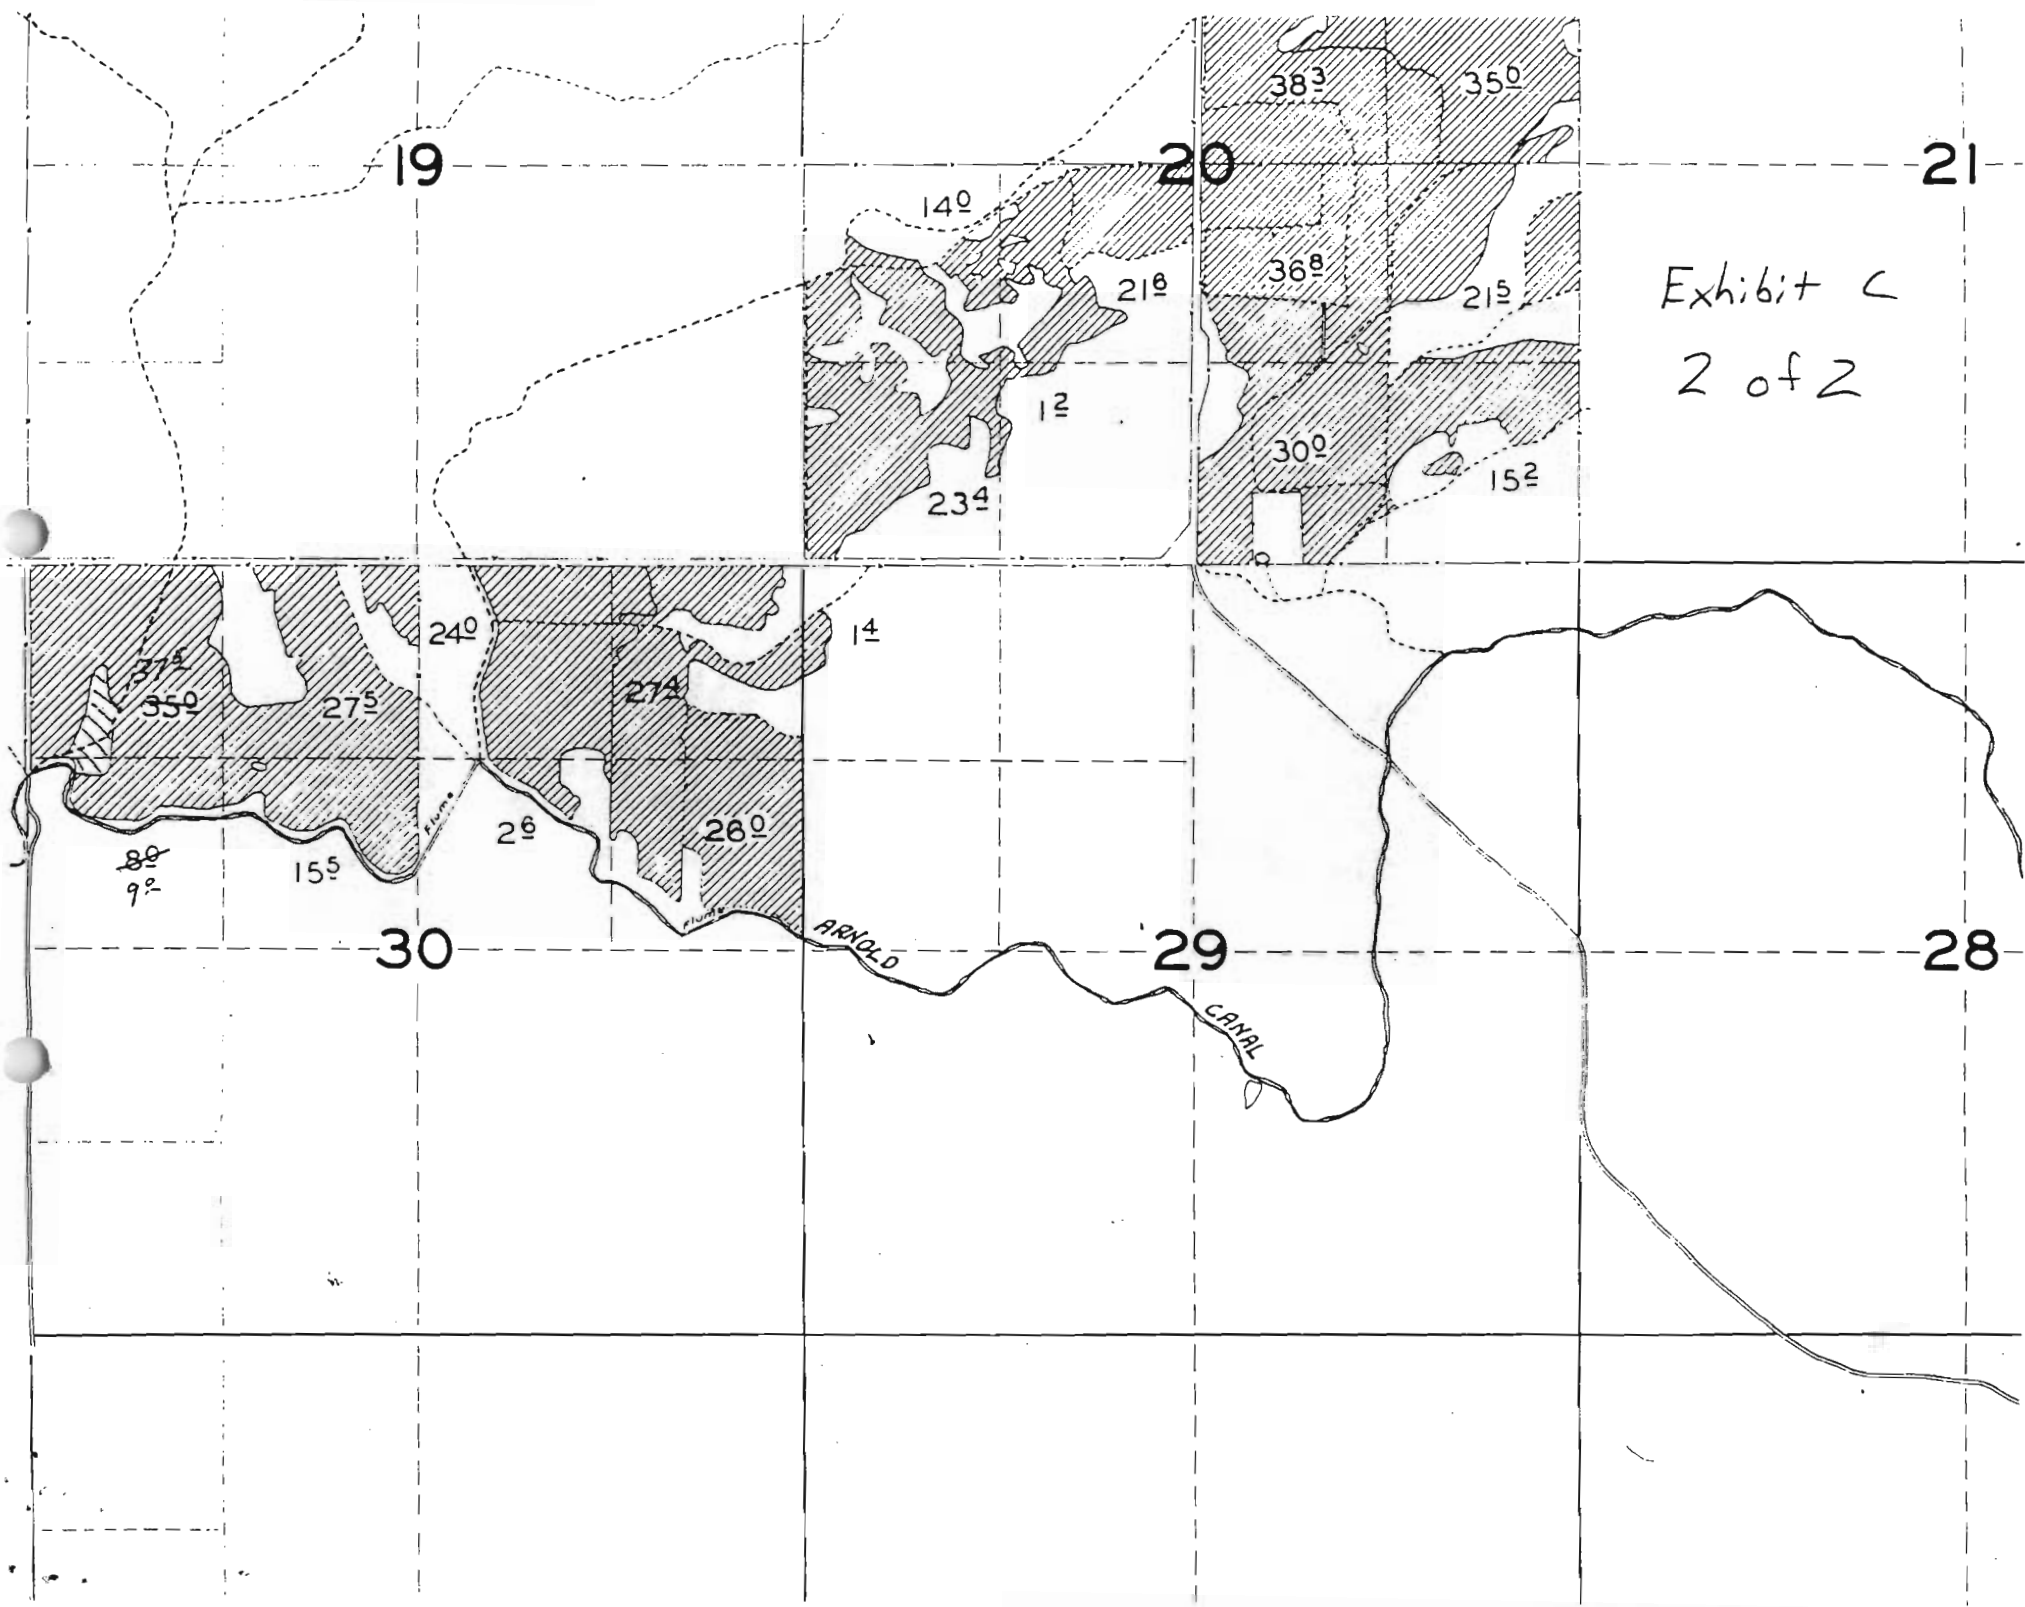


Exhibit C
2 of 2

ARNOLD MARKET RD

LOT LINE AJUSTMENT
WATER RIGHTS
FOR TAX LOTS
6000, 6004 & 6006
IN THE NE 1/4 SEC. 30,
T. 18 S., R. 13 E., W.M.,
DESCHUTES COUNTY, OREGON

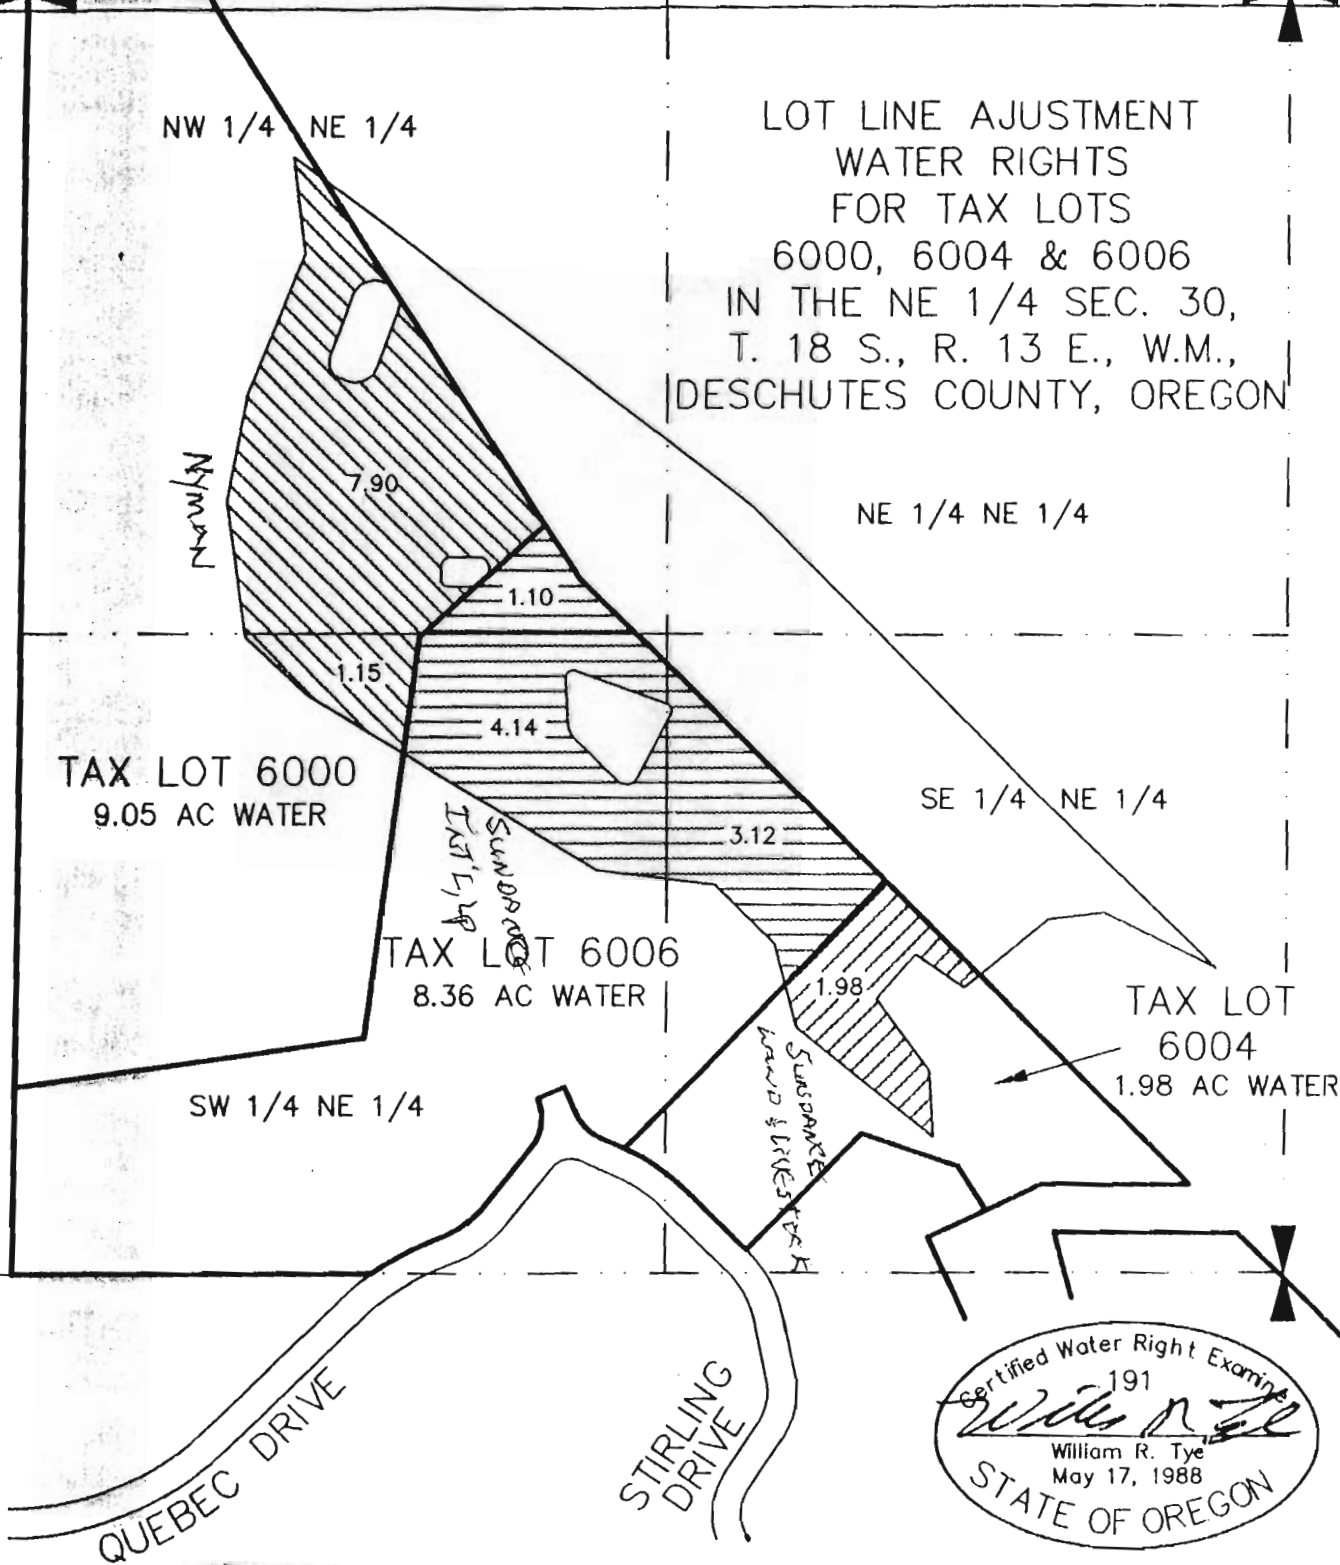

TYE ENGINEERING, INC.

725 NW HILL, BEND, OREGON 97701 (503) 389-6959

DATE: DEC. 28, 1995

SCALE: 1"=400'

DRAWN BY: P.A.T.

DWG #: 380-WR