





Permit
(Pending
Transfer)

T. 25 S. R. 6 W. W.M.

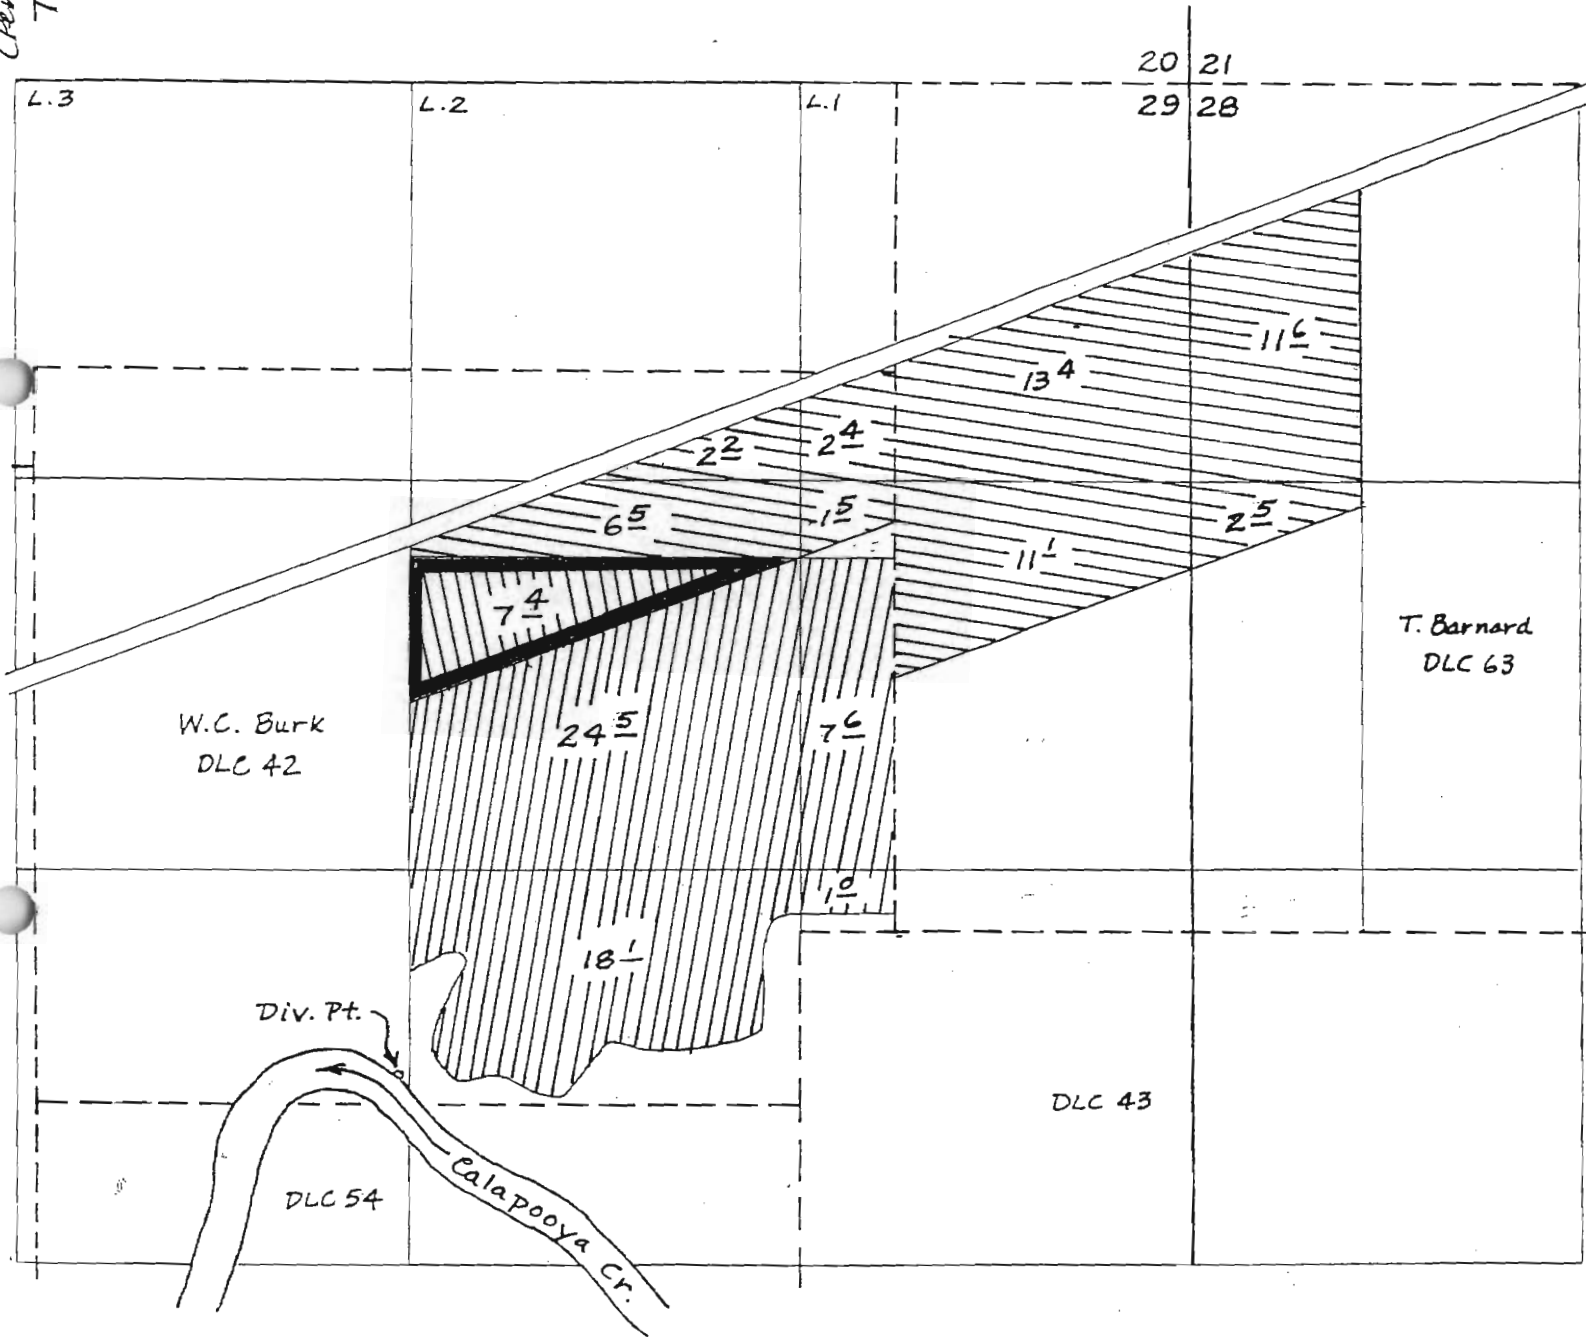

20 21
29 28

N

-  Transfer from
-  Transfer to
-  Unchanged

Scale: 8" = 1 mile

Div. Pt. 110' N and
1220' E from SW cor.
DLC 42