


SURVEY OCT 6, 7, 1915
TROUT CR DECREE
Cert. 49780


5 1/2
7 1/2
11 1/2
14 1/4
15 3/4
2 1/2
14
15

Range 13 E

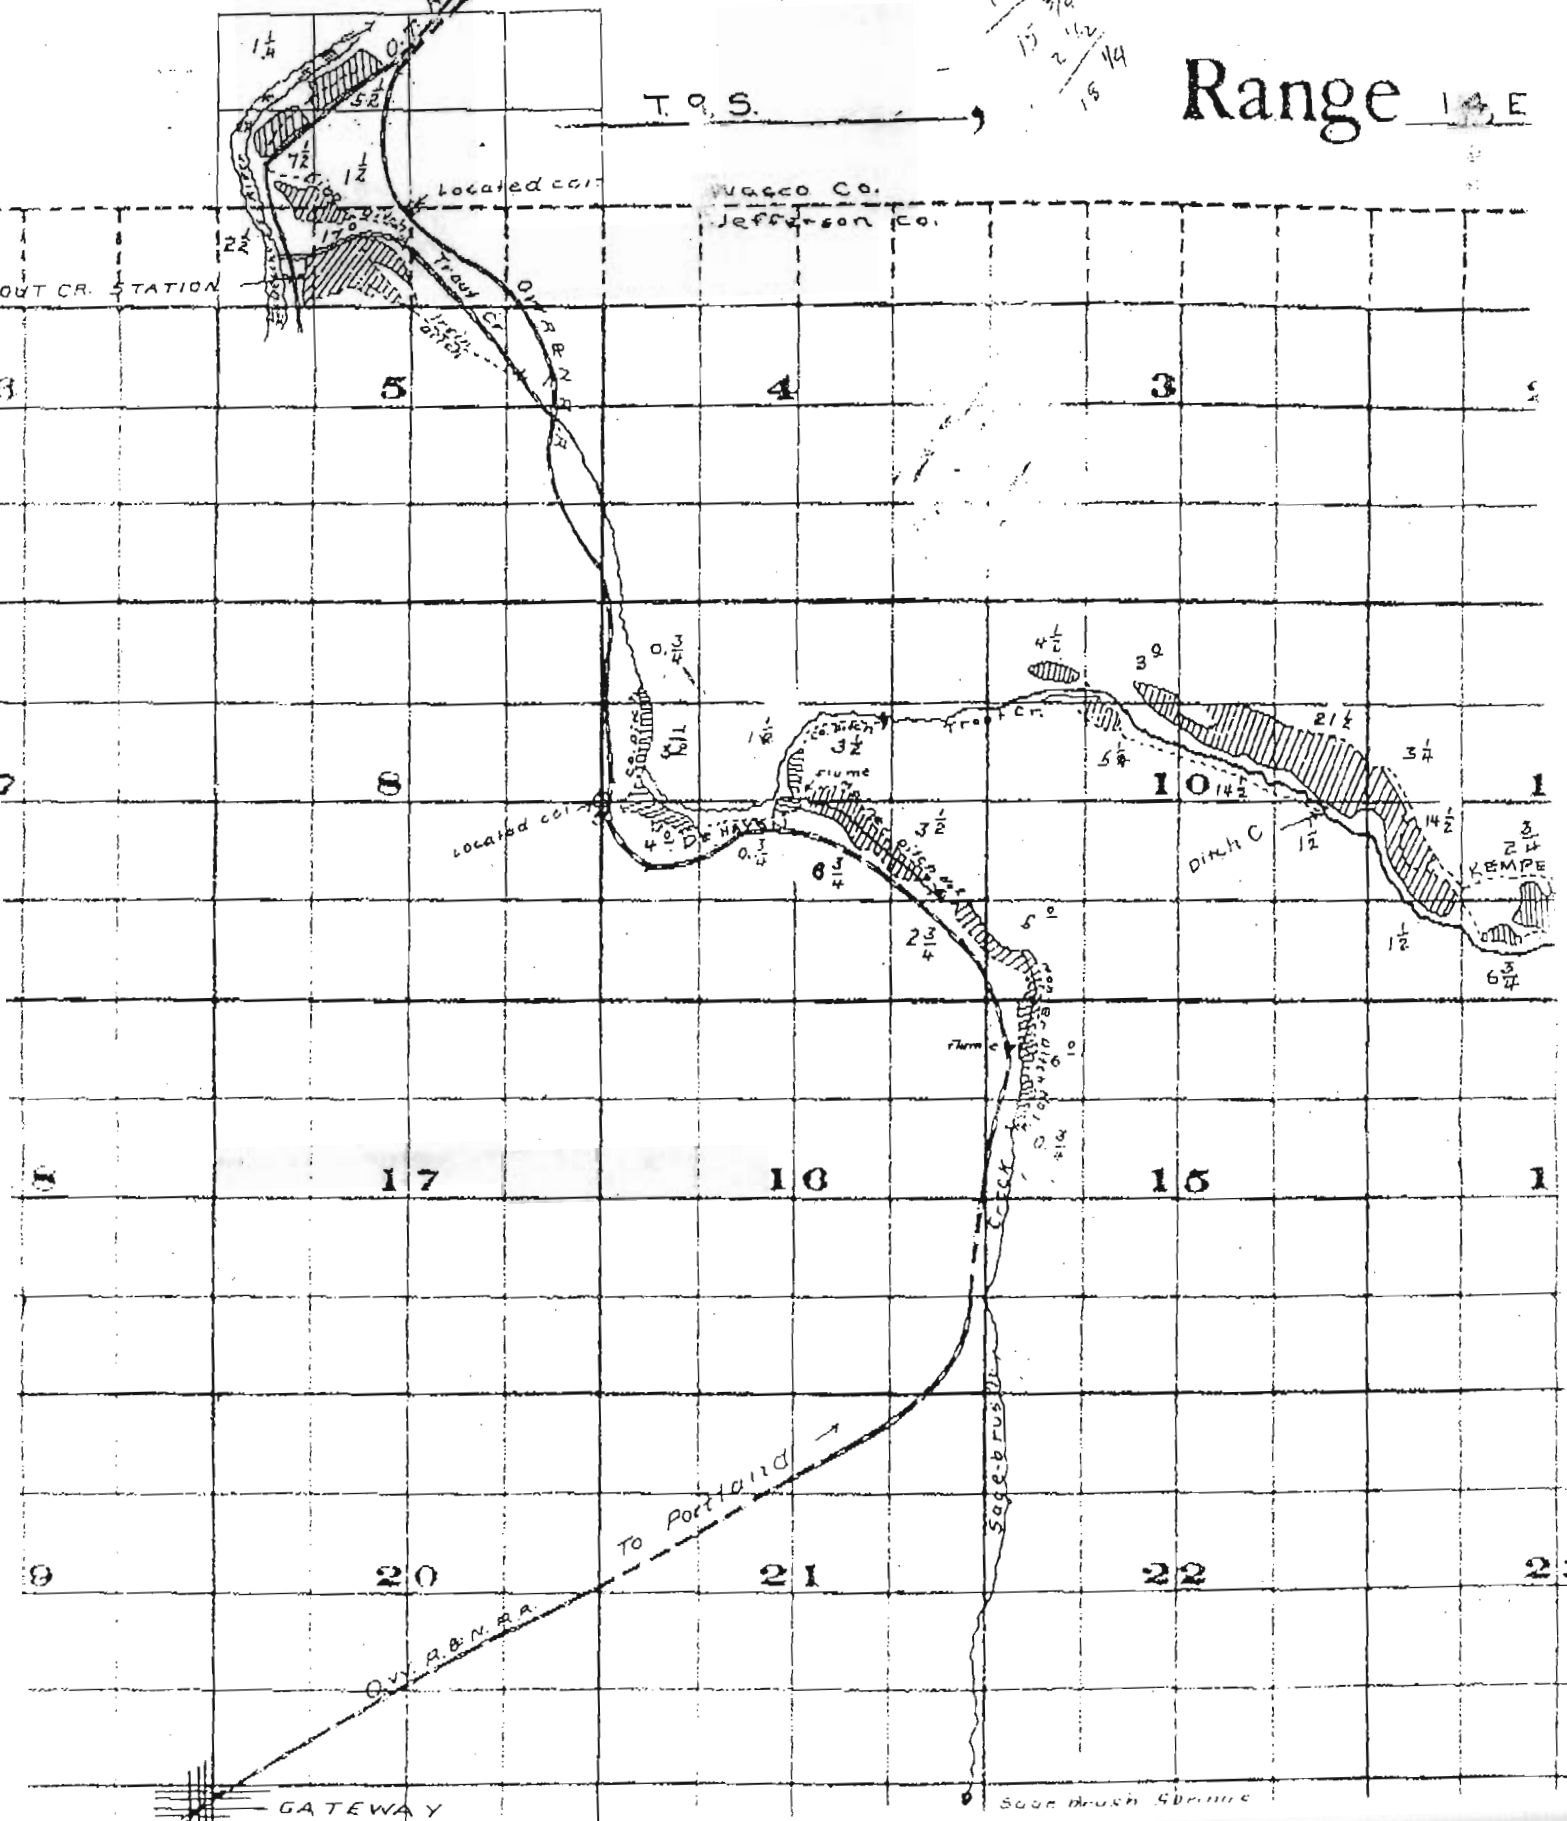

received 9-20-01

T. 9 S., R. 14 E., W.M.

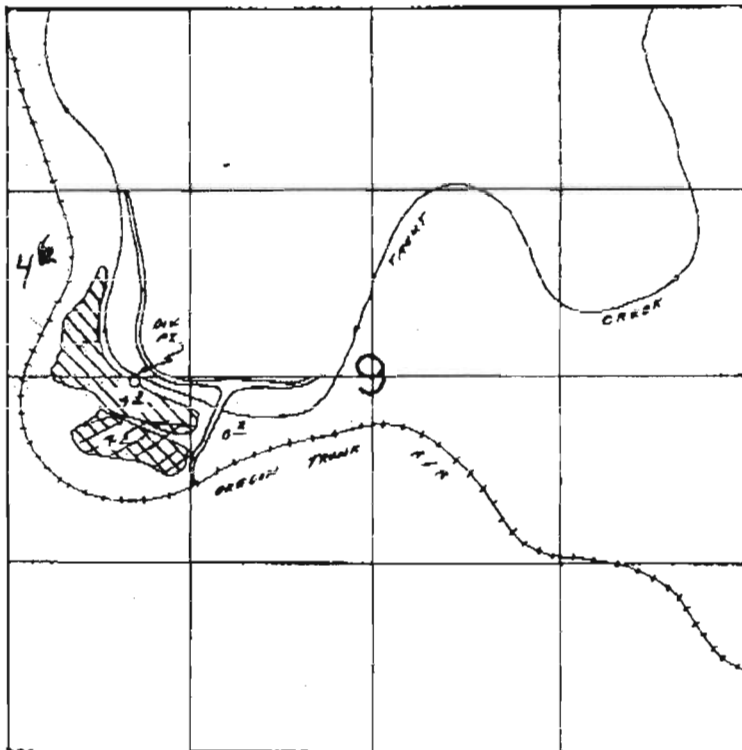

1904	1974

SW 1/4	4 6	
NW 1/4	4 2	4 2
NE 1/4	0 2	0 2

cf's	cf's
0.218	0.115

DIV. LOC: 2600' N. & 925' E FROM SW COR. SEC. 9

SCALE: 1"=1320'

Revised!

FINAL PROOF SURVEY UNDER

Date	8-31-01	# of pages	1
From	Kyle G.		
Co.			
Phone #			
Fax #			

Post-it® Fax Note 7671

To Ed Goodman
 Co./Dept.
 Phone #
 Fax #

RECEIVED

DATE 5-23-89
 WATER MASTER DISTRICT #11
 BY BMS

Application No. 52551... Permit No. 40701... Cert # 61134

IN NAME OF

JOE G. AUSTIN

Surveyed AUG. 9 1988, by B. BISHOP