


T.38&4S.R.14E.W.M.

Exhibit D - Page 1

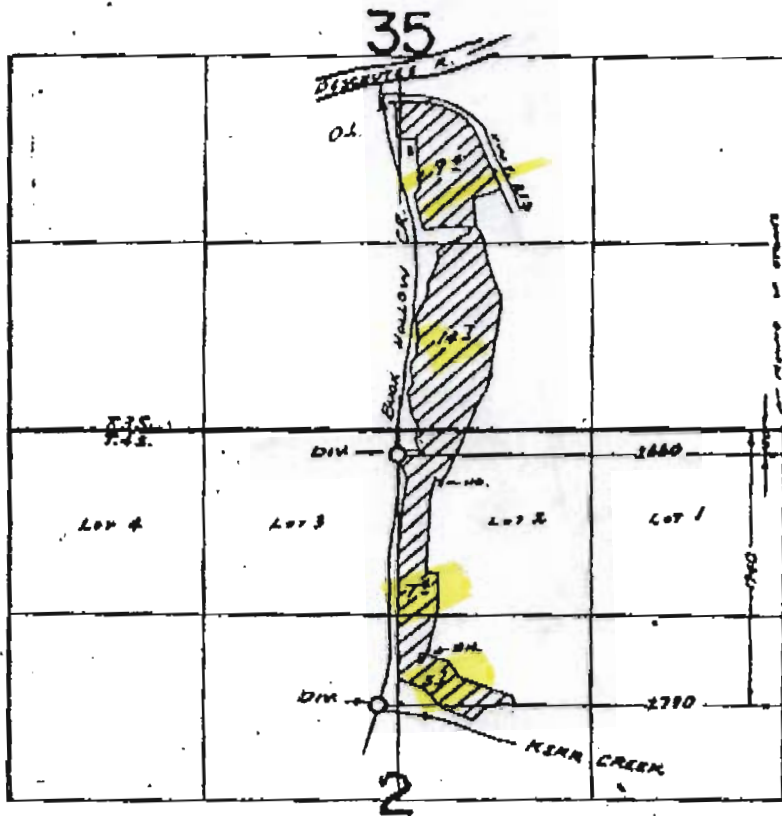

FINAL PROOF SURVEY

UNDER

Application No. 38284 Permit No. 28518


IN NAME OF \




ERNEST O. & AGNES M. WEBB

Surveyed Oct. 22, 1920, by R. MUSKEN

T. 38 & 4S. R. 14E. W.M.

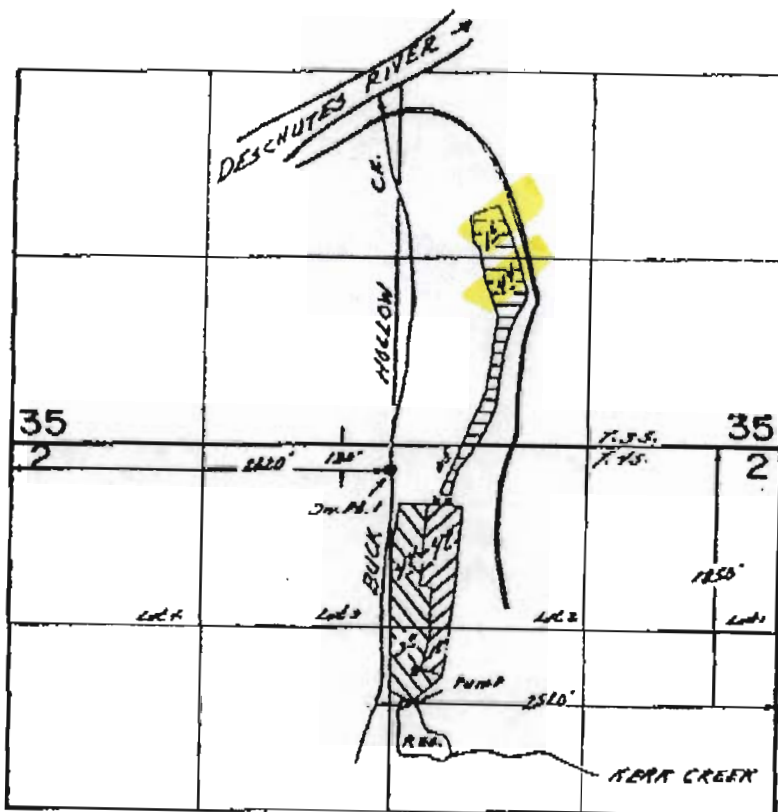Exhibit D-Page 2

 

-  - Primary from Buck Hollow Creek
-  - Primary from Kerr Cesse ! Reservoir
-  - Supply from Kerr Cesse ! Reservoir

FINAL PROOF SURVEY
 UNDER

R-49118 R-6150
 Application No. 49119... Permit No. 38057....
 IN NAME OF

..... **AGNES WEBB**

Surveyed Sept. 12, 1979, by G.R. RODRIGUEZ.

PD-1978-N-4065-427-2