


**EXHIBIT D**

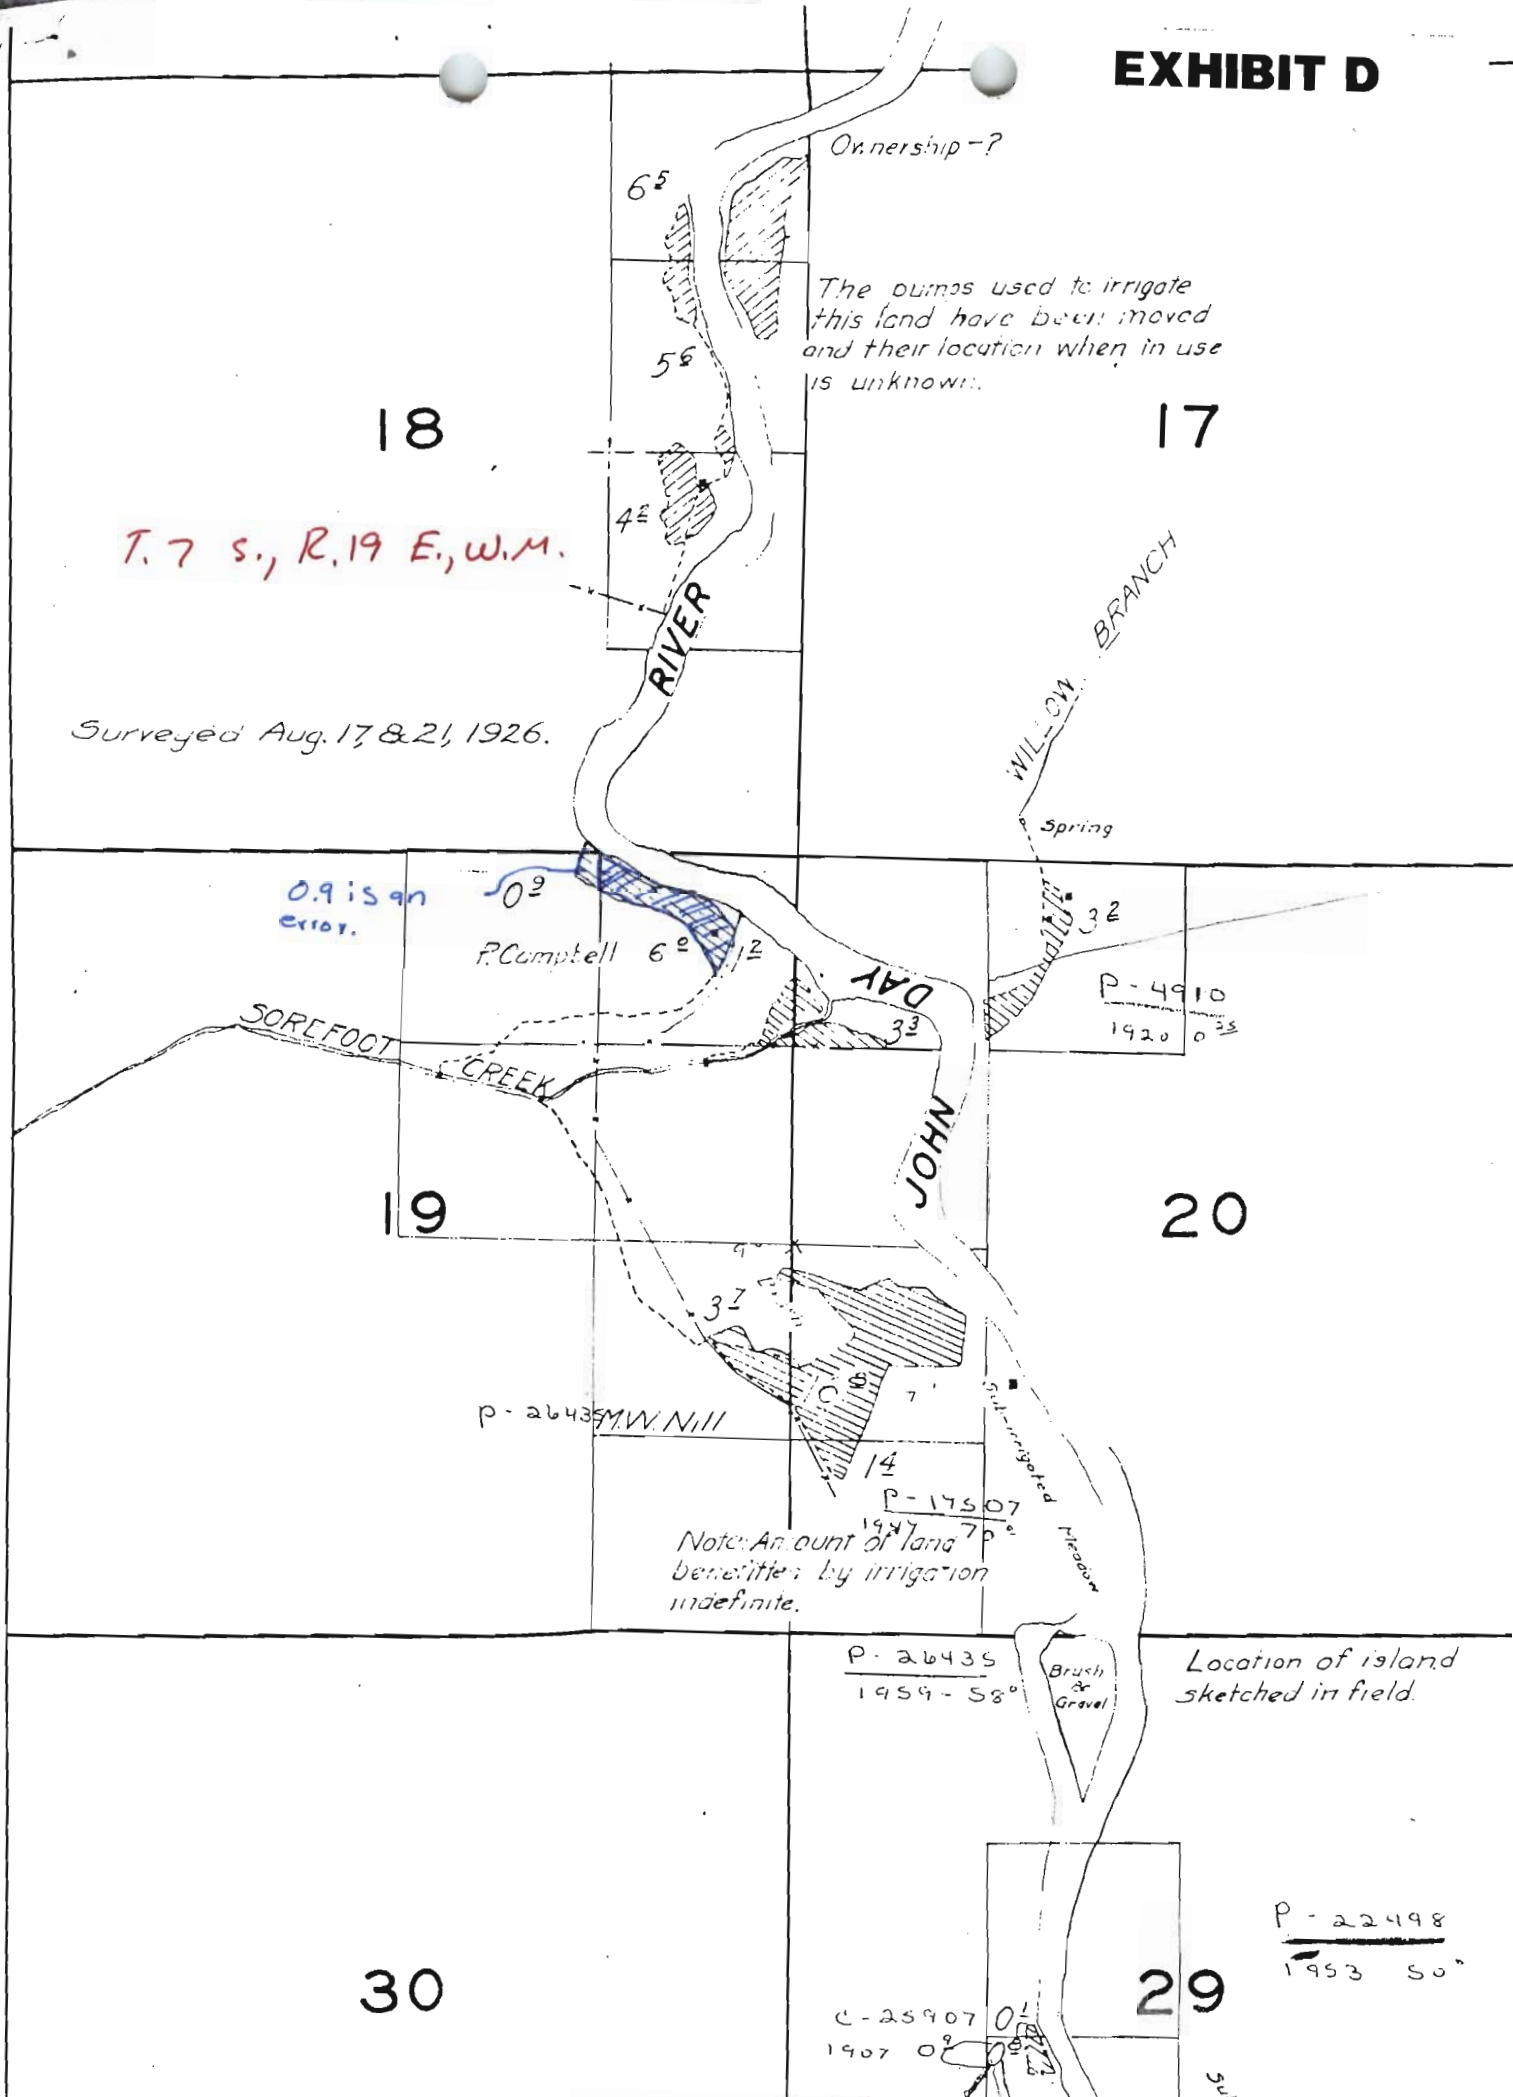

Ownership - ?

The pumps used to irrigate this land have been moved and their location when in use is unknown.

18

17

T. 7 S., R. 19 E., W.M.

Surveyed Aug. 17 & 21, 1926.

0.9 is an error.

P. Campbell 6<sup>e</sup>

P-4910  
1920 0 33

SOREFOOT CREEK

JOHN RIVER

WILLOW BRANCH

Spring

19

20

p-26435 MW N III

P-17507  
1947 7P

Note: Amount of land benefited by irrigation indefinite.

P-26435  
1959-58°

Brush & Gravel

Location of island sketched in field.

30

29


P-22498  
1953 50°

C-25907  
1907 0 2


Sub

**EXHIBIT B**

SCALE 1" = 4000'

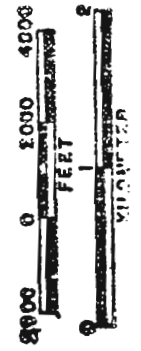

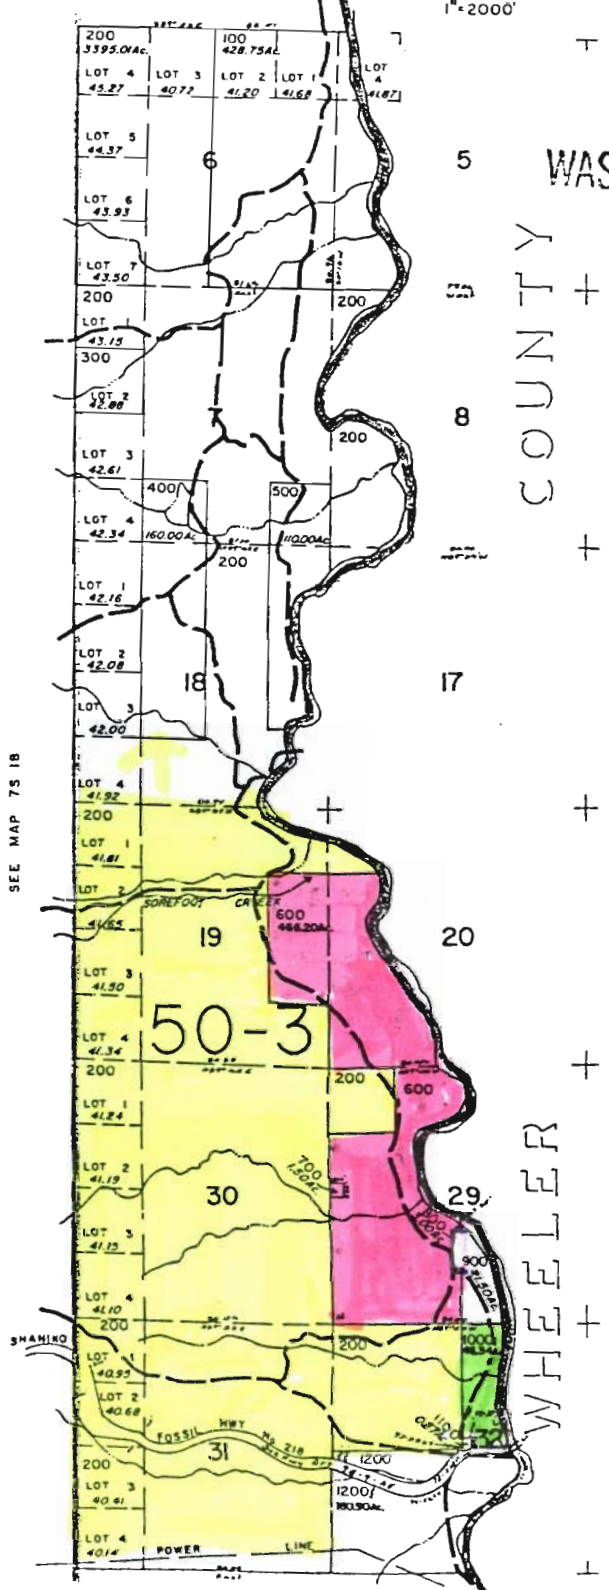

RECEIVED  
 SEP 19 1996  
 DEPT. OF REVENUE  
 STATE OF OREGON



75 19

CANCELLED NO'S  
1300  
1400

 } BLM

 } BLM acquired from  
 private ownership