

**Instream Transfer**  
**37S 2W 20AA Tax lot 600**  
**Section 20 NENE 1.51 Acres**

- District Boundary USBR
- Road Labels
- Township Range
- Sections
- Section Labels
- Quarters
- Quarter Labels
- Quarter Quarters
- Quarter Quarters Labels
- Lot Labels
- Taxlots
- Waterbodies JACK CO
- Place of Use WORKING

**RECEIVED**  
**JUN 28 2006**  
**WATER RESOURCES DEPT**  
**SALEM, OREGON**

[www.geoirrigation.com](http://www.geoirrigation.com)

*DISCLAIMER: This map is intended for display purposes only and is not intended for any legal representations. There are no warranties, expressed or implied, that accompany this product.*

Powered By  
 geoirrigation



scale 1" = 400.00'  
 created: 4/25/2006

*new land*

RECEIVED

JUN 28 2006

RESOURCES DEPT  
ALEM, OREGON

INTRODUCTION | HELP | DISCLAIMER | DATA DICTIONARY | SMARTMAP | JACKSON COUNTY **Front Counter Application**

ZOOM TO REGION ZOOM IN ZOOM OUT ZOOM BACK ZOOM FULL PAN SELECT TAXLOT DESELECT TAXLOT BUFFER TAXLOT PRINT MAP ASSESSOR MAP Intro & Tips Search Map Layers

Back New Search Text Only Mode


### ASSESSMENT & PLANNING DETAILS

Account Details Sales Deed Card  
Overlay Report Permit Details Tax Report

Click to zoom map to this taxlot.

Account 1-046477-6

Map & TaxLot	372W20AA 600 pdf
Tax Code	49-15
Acreage	1.59
Zoning	SR-2.5 1.59 Ac
Property Class	401
Stat Class	164
Unit ID	170996-1
Maintenance Area	5
Neighborhood	000
Study Area	07
Account Status	ACTIVE
Tax Status	ASSESABLE
Sub Type	NORMAL
Owner	IRVING TROY/KAREN
Situs Address	1896 OLD MILITARY RD MEDFORD/COUNTY R
Mailing Address	IRVING TROY/KAREN 1249 GREEN PARK DR CENTRAL POINT OR, 97502

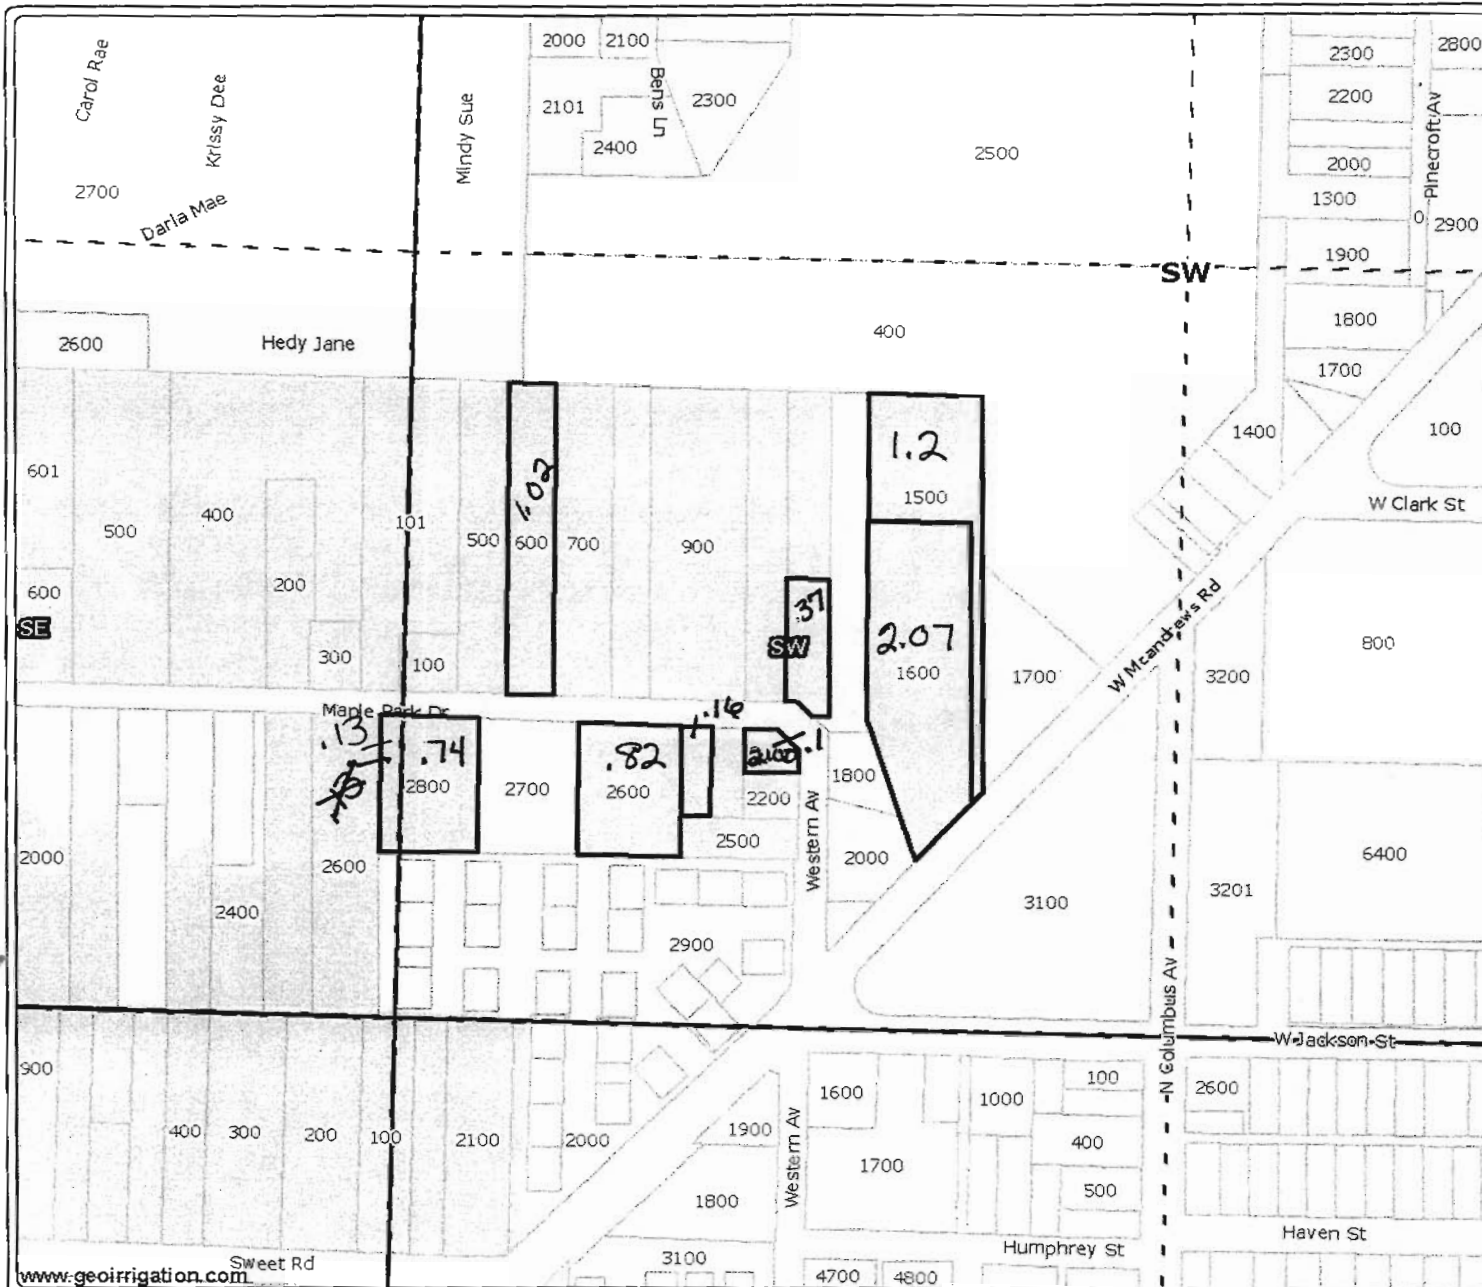

**INSTREAM TRANSFER**

37 South, Range 2 West,  
Section 24 SWSW

**6.48 Acres**  
**+ .13 Section**  
**23 SESE**

- District Boundary USBR
- Road Labels
- Township Range
- Sections
- Section Labels
- Quarters
- Quarter Labels
- Quarter Quarters
- Quarter Quarters Labels
- Lot Labels
- Taxlots
- Waterbodies JACK CO
- Irrigation Ditches JACK CO
- Place of Use WORKING

**RECEIVED**

**JUN 28 2006**

**WATER RESOURCES DEPT**  
**SALEM, OREGON**




scale 1" = 400.00'  
created: 6/8/2006

DISCLAIMER: This map is intended for display purposes only and is not intended for any legal representations.  
There are no warranties, expressed or implied, that accompany this product.

Powered By  
geoirrigation

new land

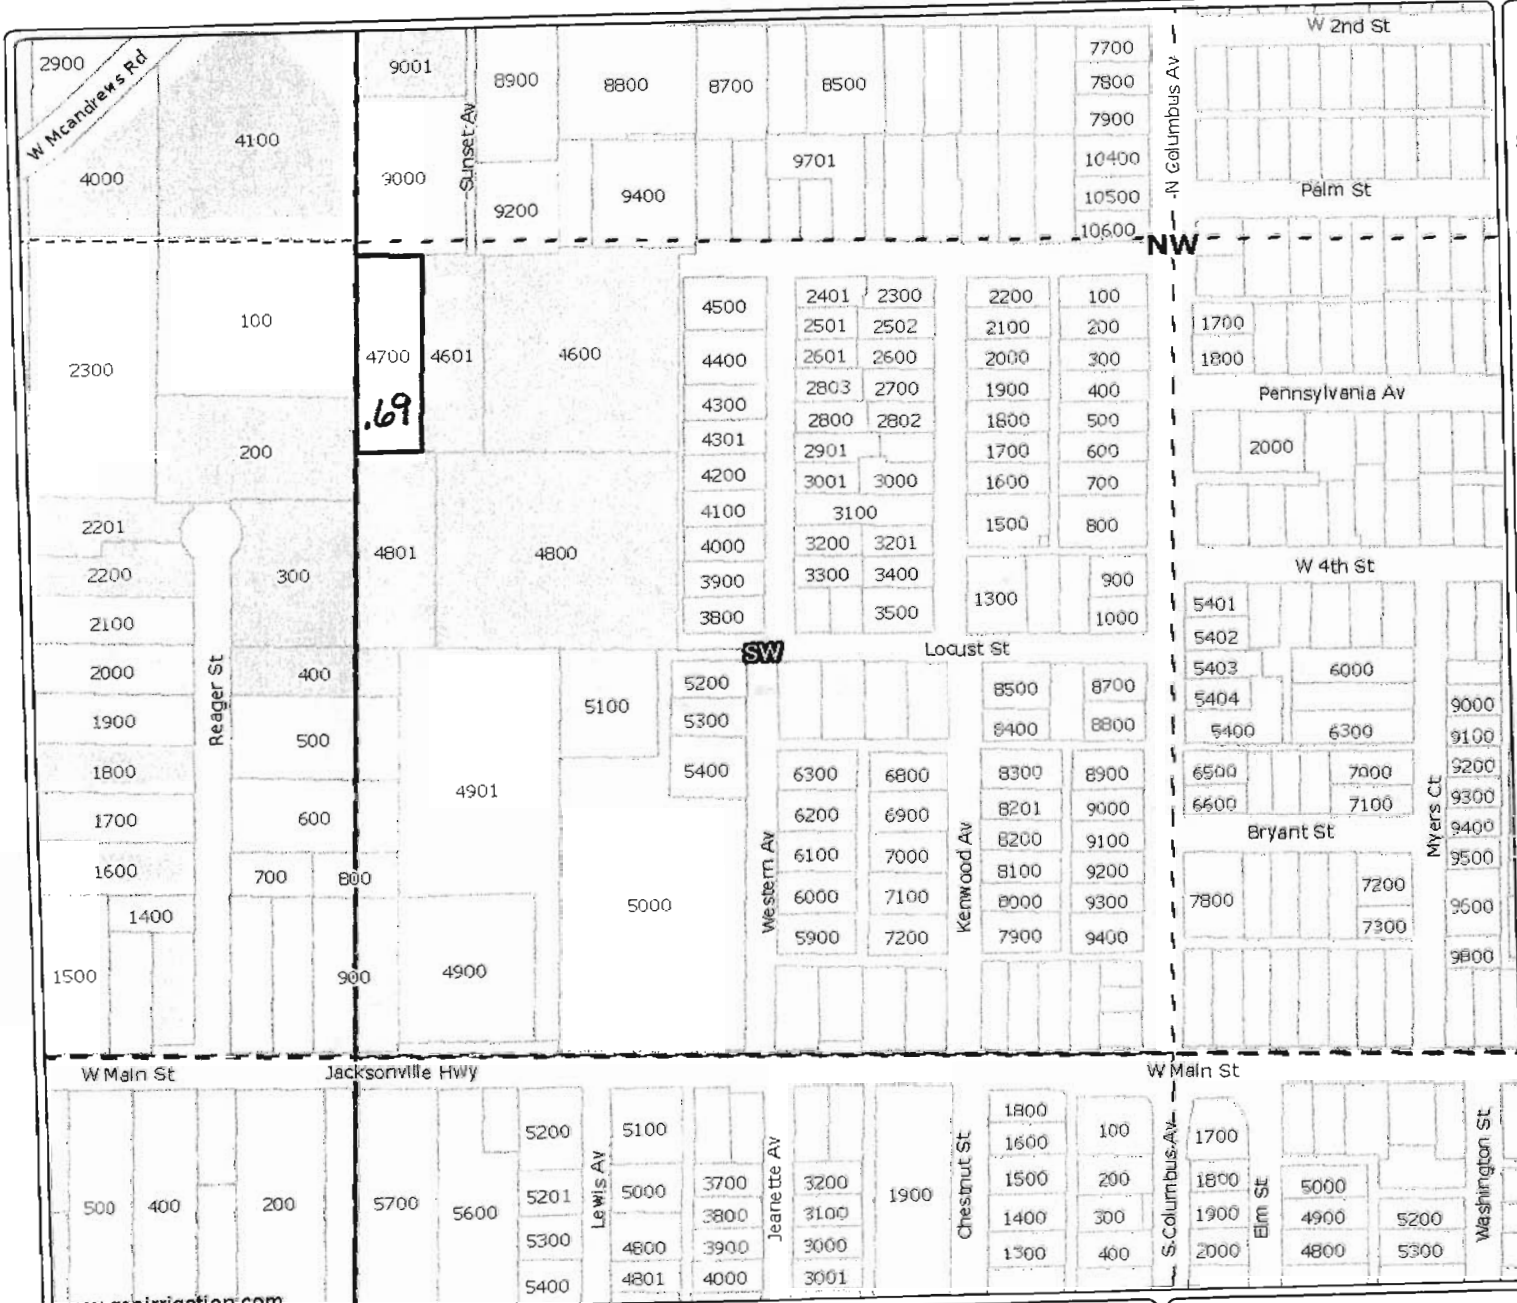

**INSTREAM TRANSFER**  
 Map 37 South, Range 2 West,  
 Section 25 SWNW 0.69 Acres

- District Boundary USBR
- Road Labels
- Township Range
- Sections
- Section Labels
- Quarters
- Quarter Labels
- Quarter Quarters
- Quarter Quarters Labels
- Lot Labels
- Taxlots
- Waterbodies JACK CO
- Irrigation Ditches JACK CO
- Place of Use WORKING

**RECEIVED**  
 JUN 28 2006

WATER RESOURCES DEPT  
 SALEM, OREGON



scale 1" = 400.00'  
 created: 6/6/2006

www.geoirrigation.com


DISCLAIMER: This map is intended for display purposes only and is not intended for any legal representations.  
 There are no warranties, expressed or implied, that accompany this product.

Powered By  
 geoirrigation

new land

**INSTREAM TRANSFER**  
**37S 2W Section 25 SWSW**  
**5.46 Acres**

- District Boundary USBR
- Road Labels
- Township Range
- Sections
- Section Labels
- Quarters
- Quarter Labels
- Quarter Quarters
- Quarter Quarters Labels
- Lot Labels
- Taxlots
- Waterbodies JACK CO
- Place of Use WORKING

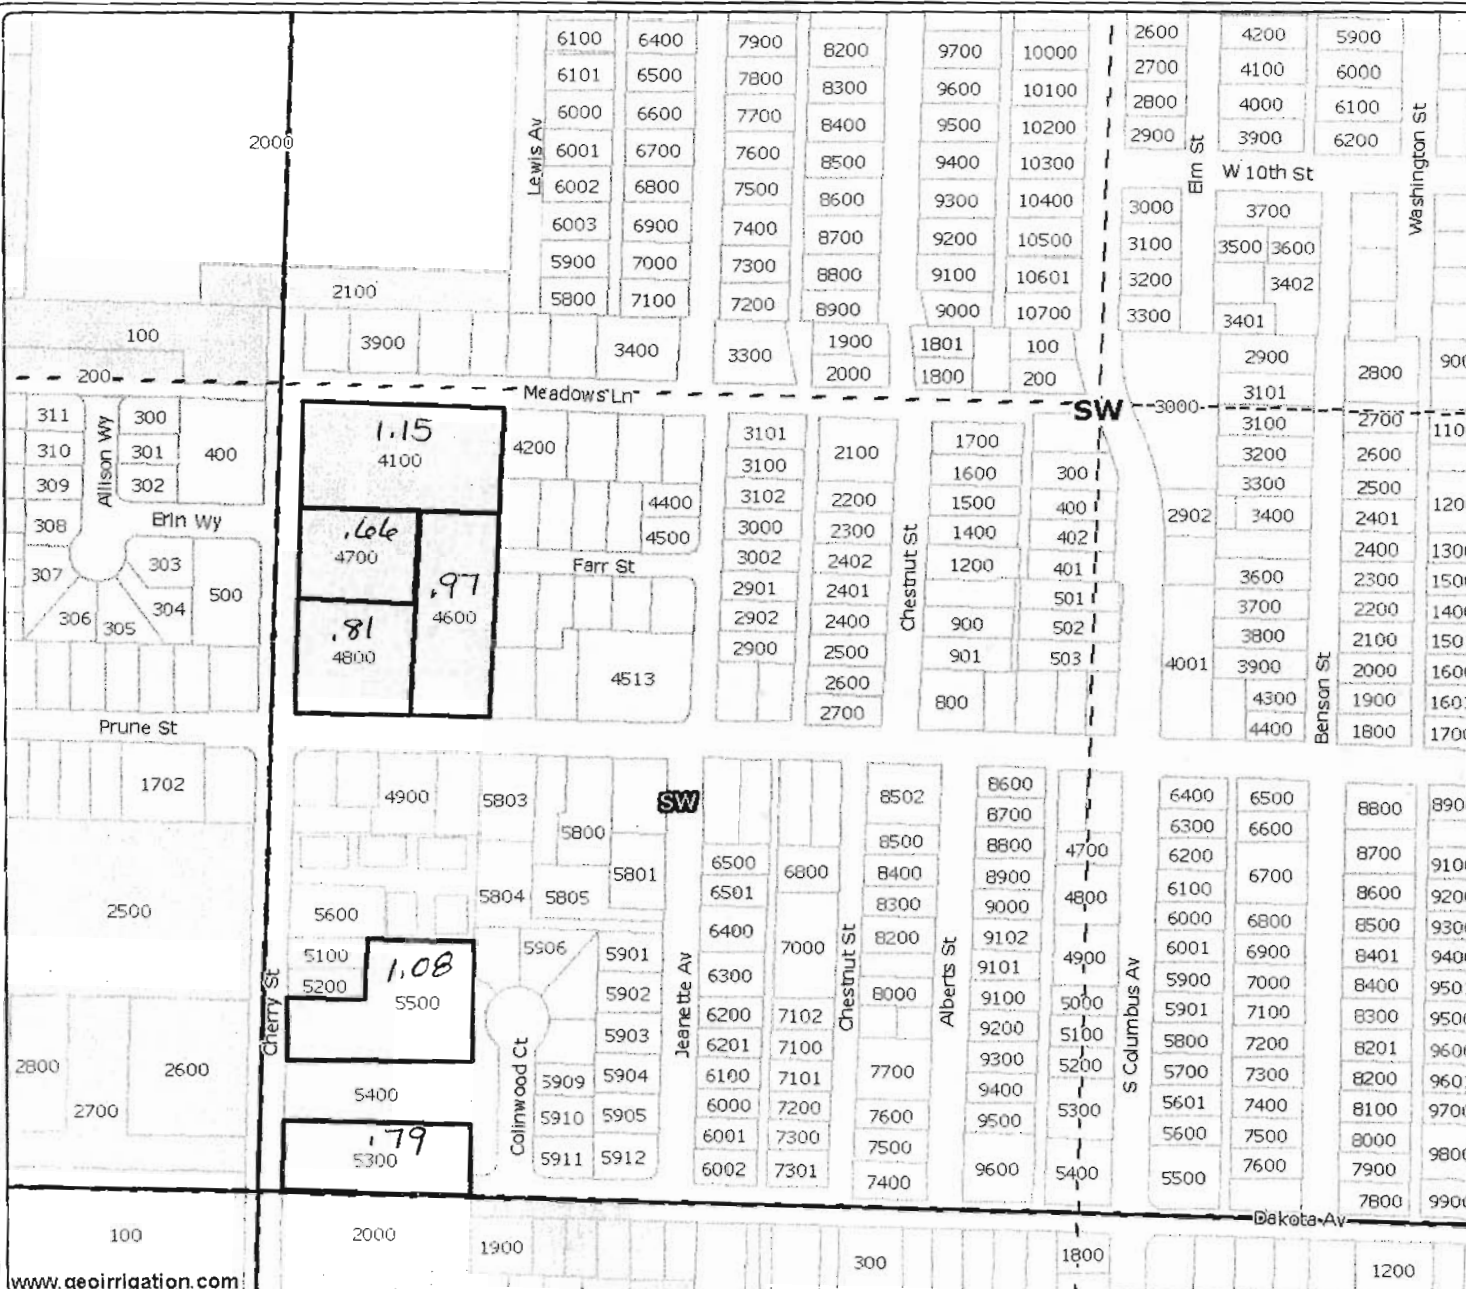

www.geoirrigation.com

**DISCLAIMER:** This map is intended for display purposes only and is not intended for any legal representations. There are no warranties, expressed or implied, that accompany this product.

Powered By  
geoirrigation



scale 1" = 400.00'  
created: 4/1/2006

new land










**RECEIVED**  
**JUN 28 2006**  
**WATER RESOURCES DEPT**  
**SALEM, OREGON**




**INSTREAM TRANSFRER**

 
37 South, Range 2 West,  
Section 26 SWNW

0.63 Acre

-  District Boundary USBR
- Road Labels
-  Township Range
-  Sections
- Section Labels
-  Quarters
- Quarter Labels
-  Quarter Quarters
- Quarter Quarters Labels
- Lot Labels
-  Taxlots
-  Waterbodies JACK CO
-  Irrigation Ditches JACK CO
-  Place of Use WORKING

**RECEIVED**  
JUN 28 2006  
WATER RESOURCES DEPT  
SALEM, OREGON


 scale 1" = 400.00'  
created: 6/7/2006

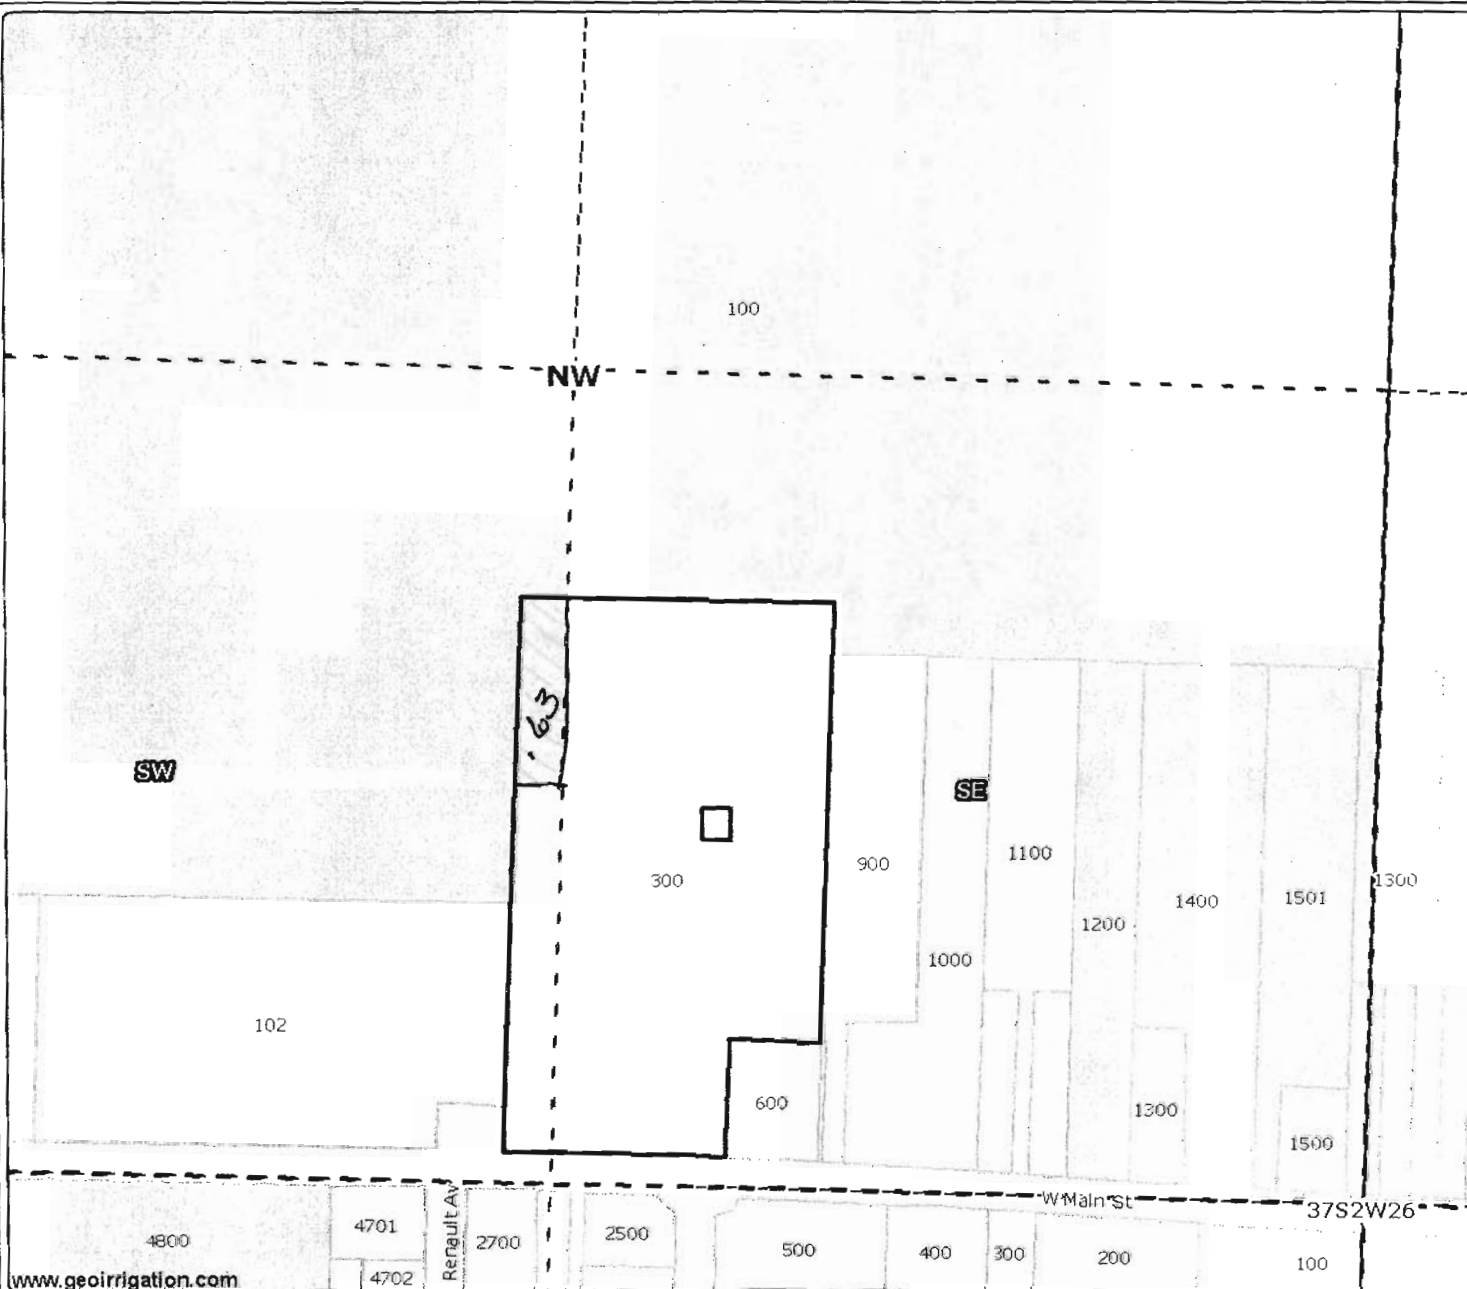

www.geoirrigation.com

DISCLAIMER: This map is intended for display purposes only and is not intended for any legal representations.  
There are no warranties, expressed or implied, that accompany this product.

Powered By  
geoirrigation

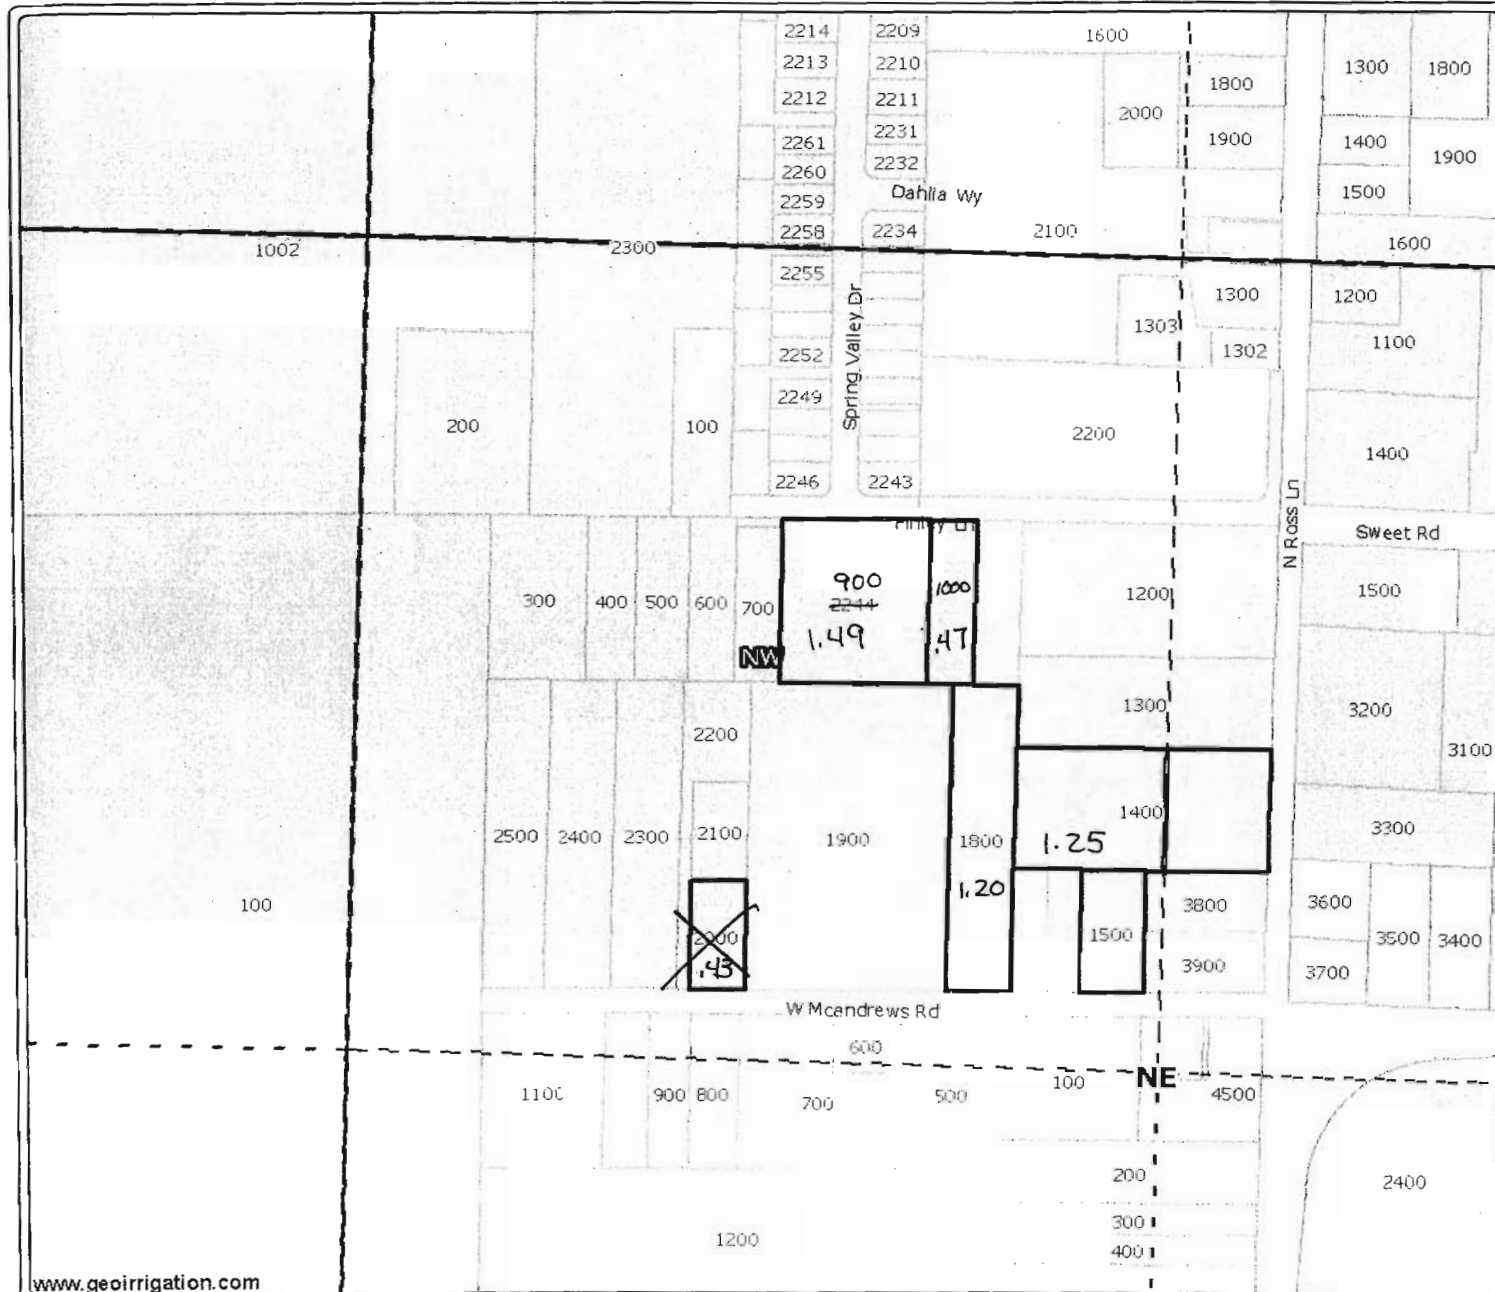

**INSTREAM TRANSFER**

37S 2W 26 NWNE

~~5.20~~ Acres

4.77

- District Boundary USBR
- Road Labels
- Township Range
- Sections
- Section Labels
- Quarters
- Quarter Labels
- Quarter Quarters
- Quarter Quarters Labels
- Lot Labels
- Taxlots
- Waterbodies JACK CO
- Place of Use WORKING

**RECEIVED**

**JUN 28 2006**

**WATER RESOURCES DEPT  
SALEM, OREGON**

[www.geoirrigation.com](http://www.geoirrigation.com)

DISCLAIMER: This map is intended for display purposes only and is not intended for any legal representations.  
There are no warranties, expressed or implied, that accompany this product.

Powered By  
geoirrigation



scale 1" = 400.00'  
created: 4/3/2006















new land



# INSTREAM TRANSFER

37 South, Range 2 West,  
Section 26 NENE

*1.61 Acres*

-  District Boundary USBR
-  Road Labels
-  Township Range
-  Sections
-  Section Labels
-  Quarters
-  Quarter Labels
-  Quarter Quarters
-  Quarter Quarters Labels
-  Lot Labels
-  Taxlots
-  Waterbodies JACK CO
-  Irrigation Ditches JACK CO
-  Place of Use WORKING

**RECEIVED**

**JUN 28 2006**

**WATER RESOURCES DEPT  
SALEM, OREGON**



scale 1" = 400.00'  
created: 6/8/2006



www.geoIrrigation.com

DISCLAIMER: This map is intended for display purposes only and is not intended for any legal representations.  
There are no warranties, expressed or implied, that accompany this product.

Powered By  
geoIrrigation



**INSTREAM TRANSFER**  
 37S 2W Section 26 SENE  
 1.72 ~~2.05~~ Acres

- District Boundary USBR
- Road Labels
- Township Range
- Sections
- Section Labels
- Quarters
- Quarter Labels
- Quarter Quarters
- Quarter Quarters Labels
- Lot Labels
- Taxlots
- Waterbodies JACK CO
- Place of Use WORKING

**RECEIVED**

**JUN 28 2006**

**WATER RESOURCES DEPT  
 SALEM, OREGON**



scale 1" = 400.00'  
 created: 4/1/2006

www.geoirrigation.com

*DISCLAIMER: This map is intended for display purposes only and is not intended for any legal representations. There are no warranties, expressed or implied, that accompany this product.*

Powered By  
 geoirrigation

new land