


T.29S, R. 4W.W.M.

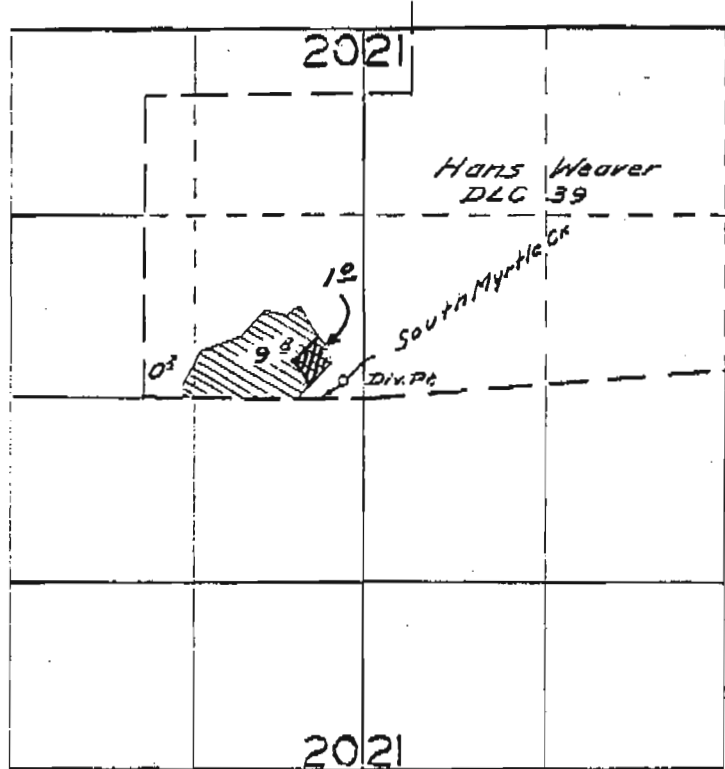

 Remaining Right (1.0 AC)

FINAL PROOF SURVEY
UNDER


Application No. 25891 Permit No. 20318
IN NAME OF

Frank L. Radford

Surveyed Aug. 31 1956, by G.O. Bartlett

20318

T.29S, R.4W.WM.

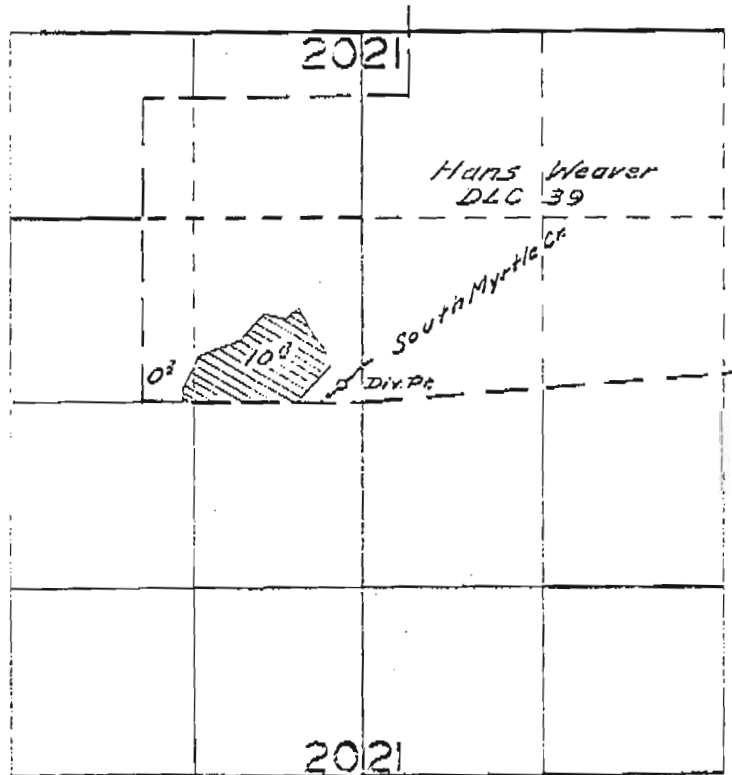

FINAL PROOF SURVEY
UNDER

Application No. 25891 Permit No. 20318
IN NAME OF

Frank L. Radford

Surveyed Aug. 31 1956, by C. O. Bartsch