


CROOK COUNTY
SEC.17 T15S. R15E. W.M.

SCALE - 1" = 400'



SE 1/4

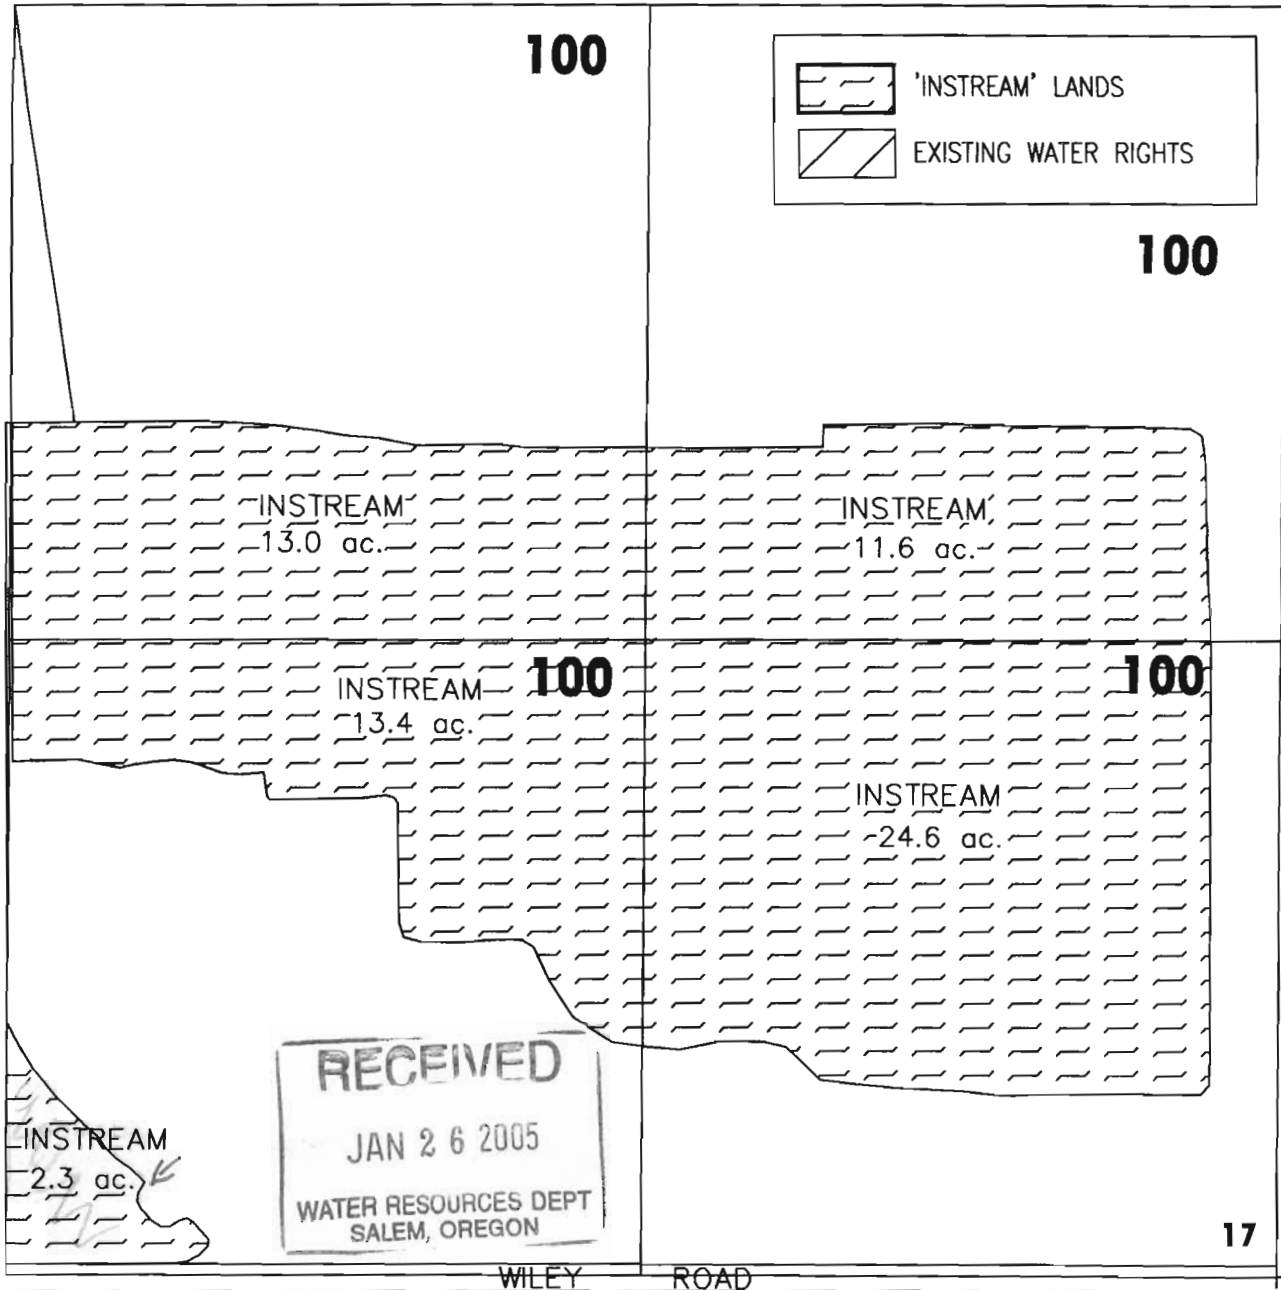

CENTRAL OREGON



IRRIGATION DISTRICT

APPLICATION FOR IN STREAM LEASE

20 21

NAME: EUGENE GRAMZOW MAP 1 OF 2

TAXLOT #: 100, 106

85.5 ACRES INSTREAM

DATE: 12-17-04


FILE NO: E:\TRANSFER\INSTREAM\INSTRM05\GRAMZOW1

CROOK COUNTY
SEC.17 T15S. R15E. W.M.

SCALE - 1" = 400'



SW 1/4

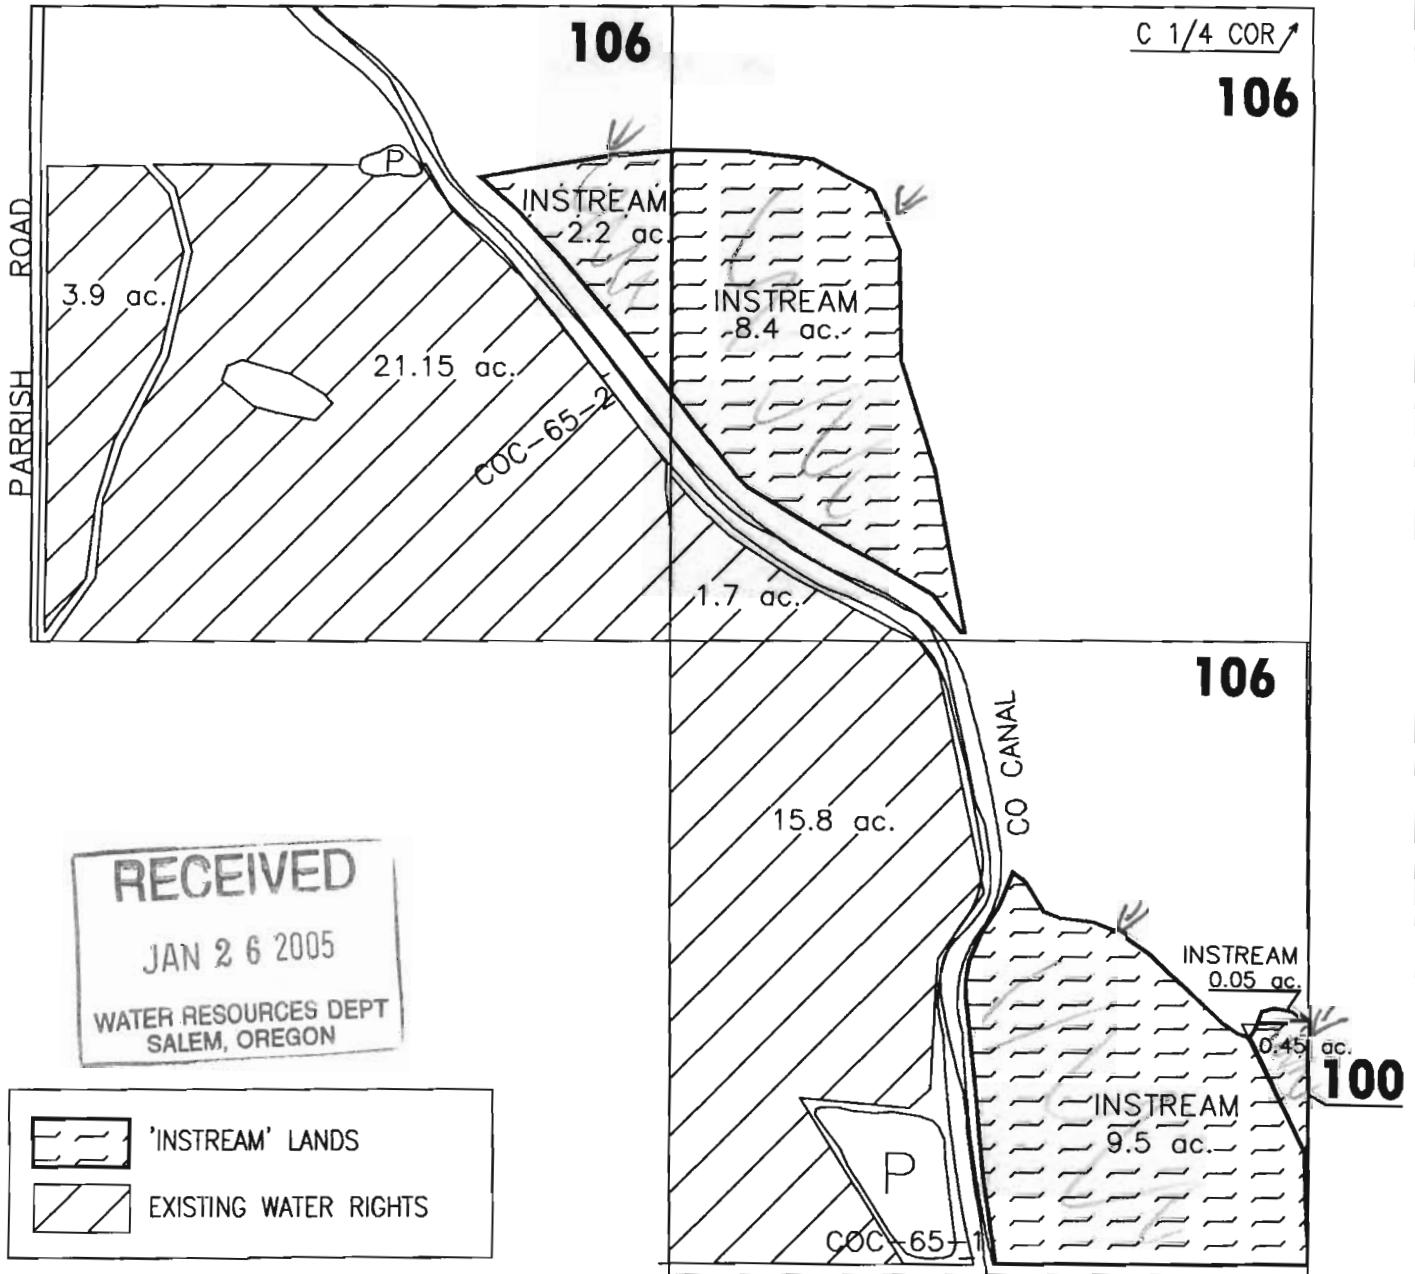

APPLICATION FOR IN STREAM LEASE
 NAME: EUGENE GRAMZOW MAP 2 OF 2
 TAXLOT #: 100, 106 85.5 ACRES INSTREAM
 DATE: 12-17-04 FILE NO: E:\TRANSFER\INSTREAM\INSTRM05\GRAMZOW