


T1S R9WWM

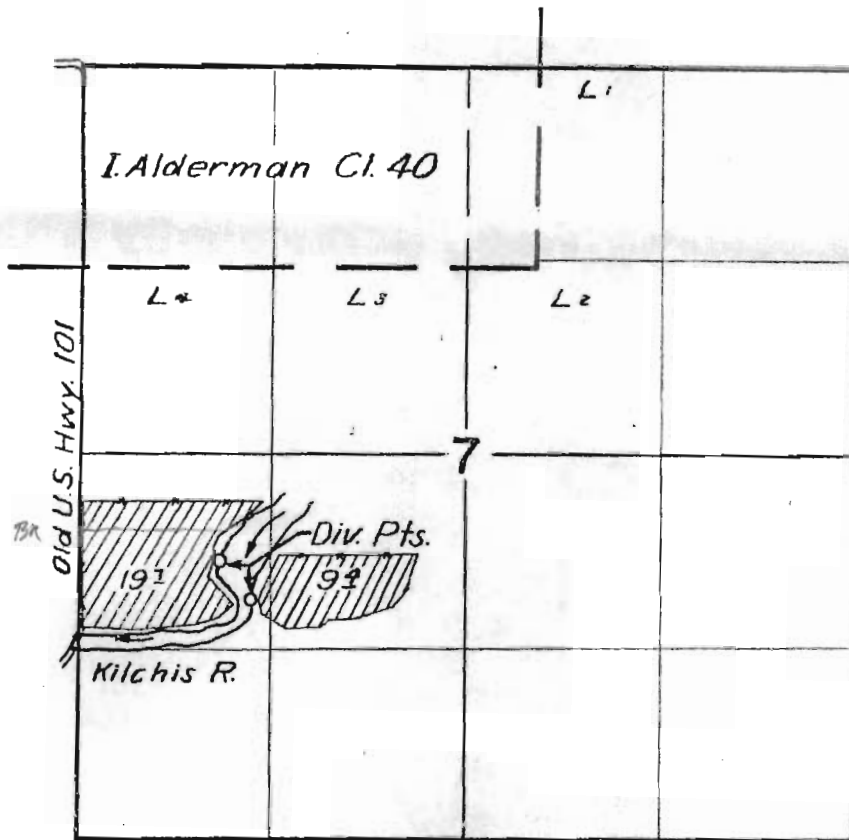

FINAL PROOF SURVEY

UNDER

Application No. 28505 Permit No. 22501

IN NAME OF

Martha Pigman

Surveyed July 7, 1955 by M. Beah

RECEIVED

MAR 04 2005


WATER RESOURCES DEPT
SALEM, OREGON

THIS MAP WAS PREPARED FOR
ASSESSMENT PURPOSE ONLY

SECTION 7 T.1S. R.9W.W.M.
TILLAMOOK COUNTY

IS 9 7

SEE MAP 15 9 6

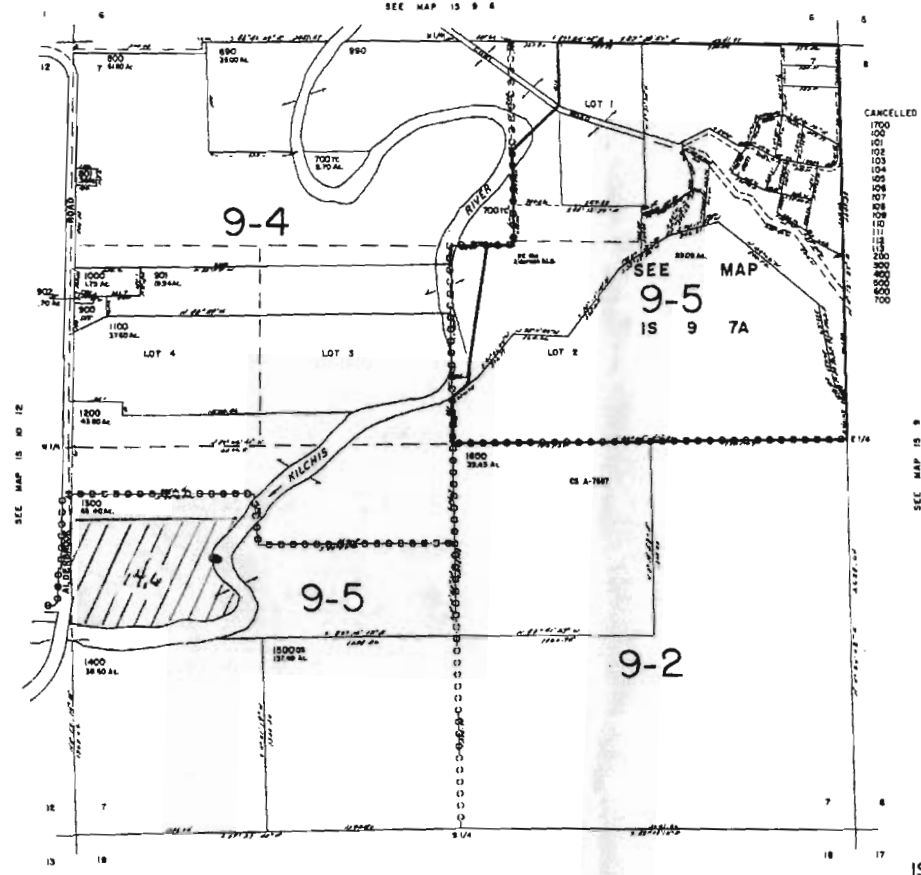

CANCELLED
 1700
 150
 151
 105
 103
 104
 105
 107
 108
RECEIVED

MAR 04 2005

WATER RESOURCES DEPT
SALEM, OREGON

IS 9 7

SEE MAP 15 9 18

REVISED 11-10-98, ONE