


# NORTH UNIT IRRIGATION DISTRICT

Section 14 T.11S. R.13E. W. M.

JEFFERSON COUNTY

1" = 400'

SEE MAP 11 13 11

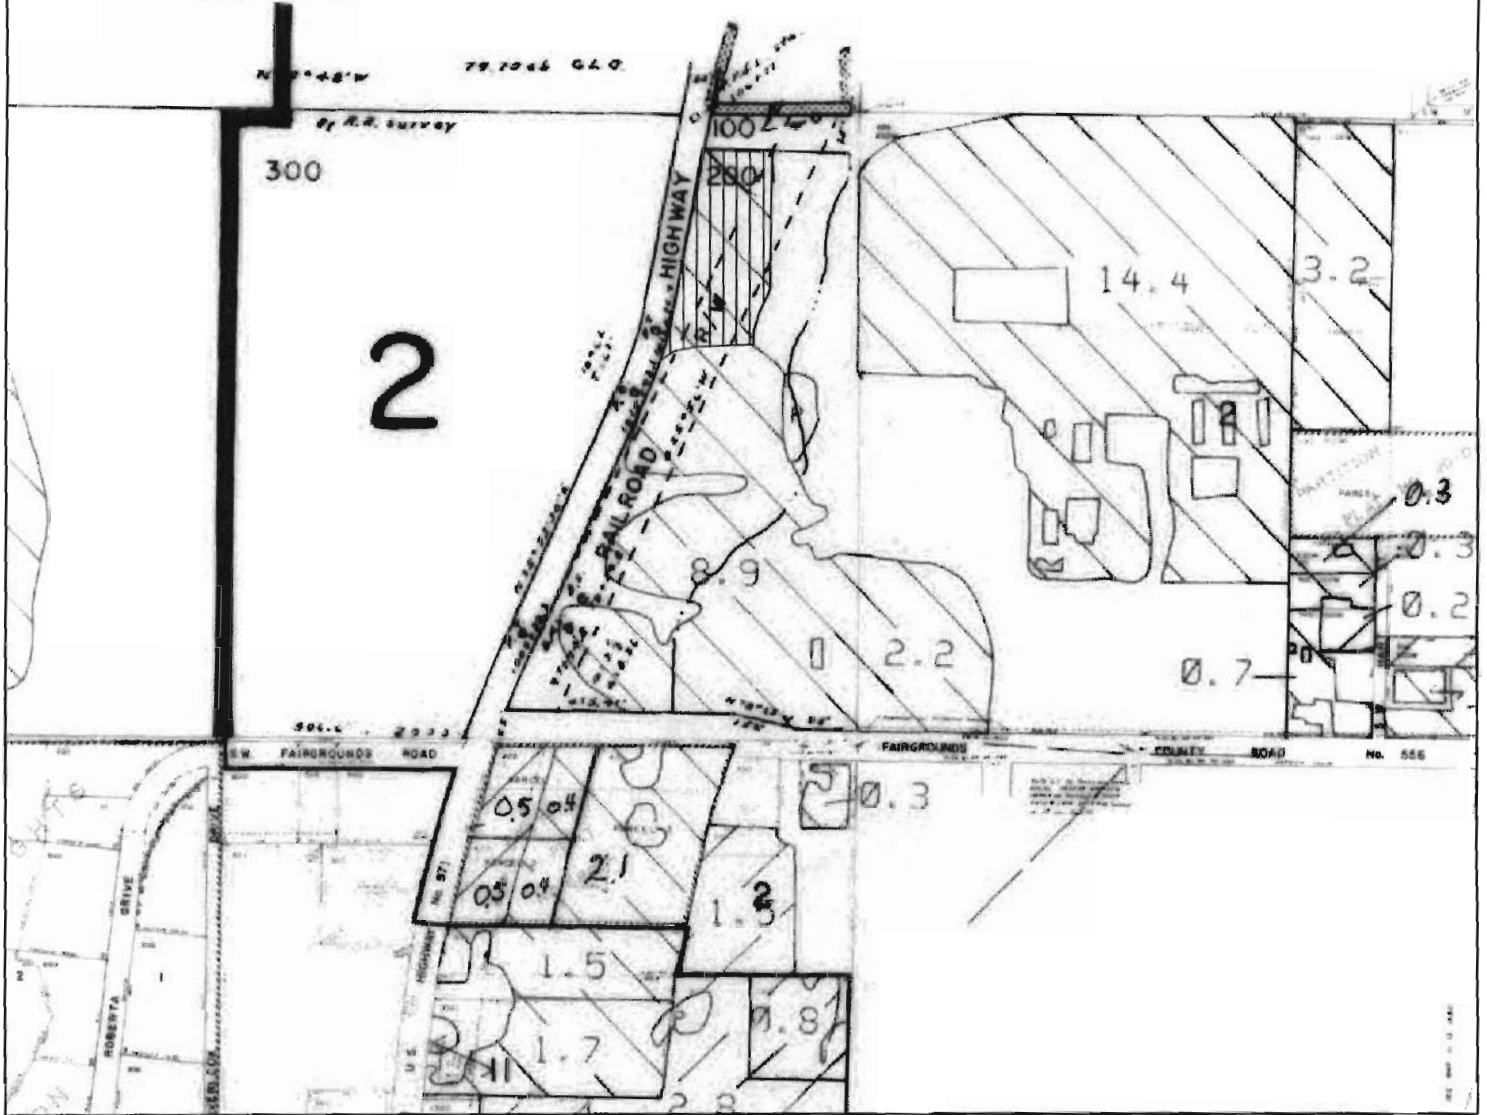

Scale 1" = 400'  
**RECEIVED**  
APR 19 2005  
WATER RESOURCES DEPT  
SALEM, OREGON

North Unit Irrigation District  
2024 NW Beech Street  
Madras OR 97741  
Phone: (541)475-3625  
Fax: (541)4753905  
email: nuid@palmain.com



Jefferson County (Fairgrounds)  
Section 14, Township 11S, Range 13E  
NWNE Tax Lot 200



INSTREAM - DESCHUTES

SEE MAP 12 13 16

COLUMBIA



39.4

900

29.7

0.4

1100

1201

6.5

1100

1200

29.9



DESCHUTES RIVER


Scale 1" = 400'


**RECEIVED**  
 APR 19 2005  
 WATER RESOURCES DEPT  
 SALEM, OREGON

North Unit Irrigation District  
 2024 NW Beech Street  
 Madras OR 97741  
 Phone: (541)475-3625  
 Fax: (541)475-3905  
 email: nuid@palmain.com



Trail Crossing Farms  
 Section 15, Township 12S, Range 13E WM  
 NWSW Tax Lot 1000

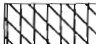 INSTREAM - DESCHUTES

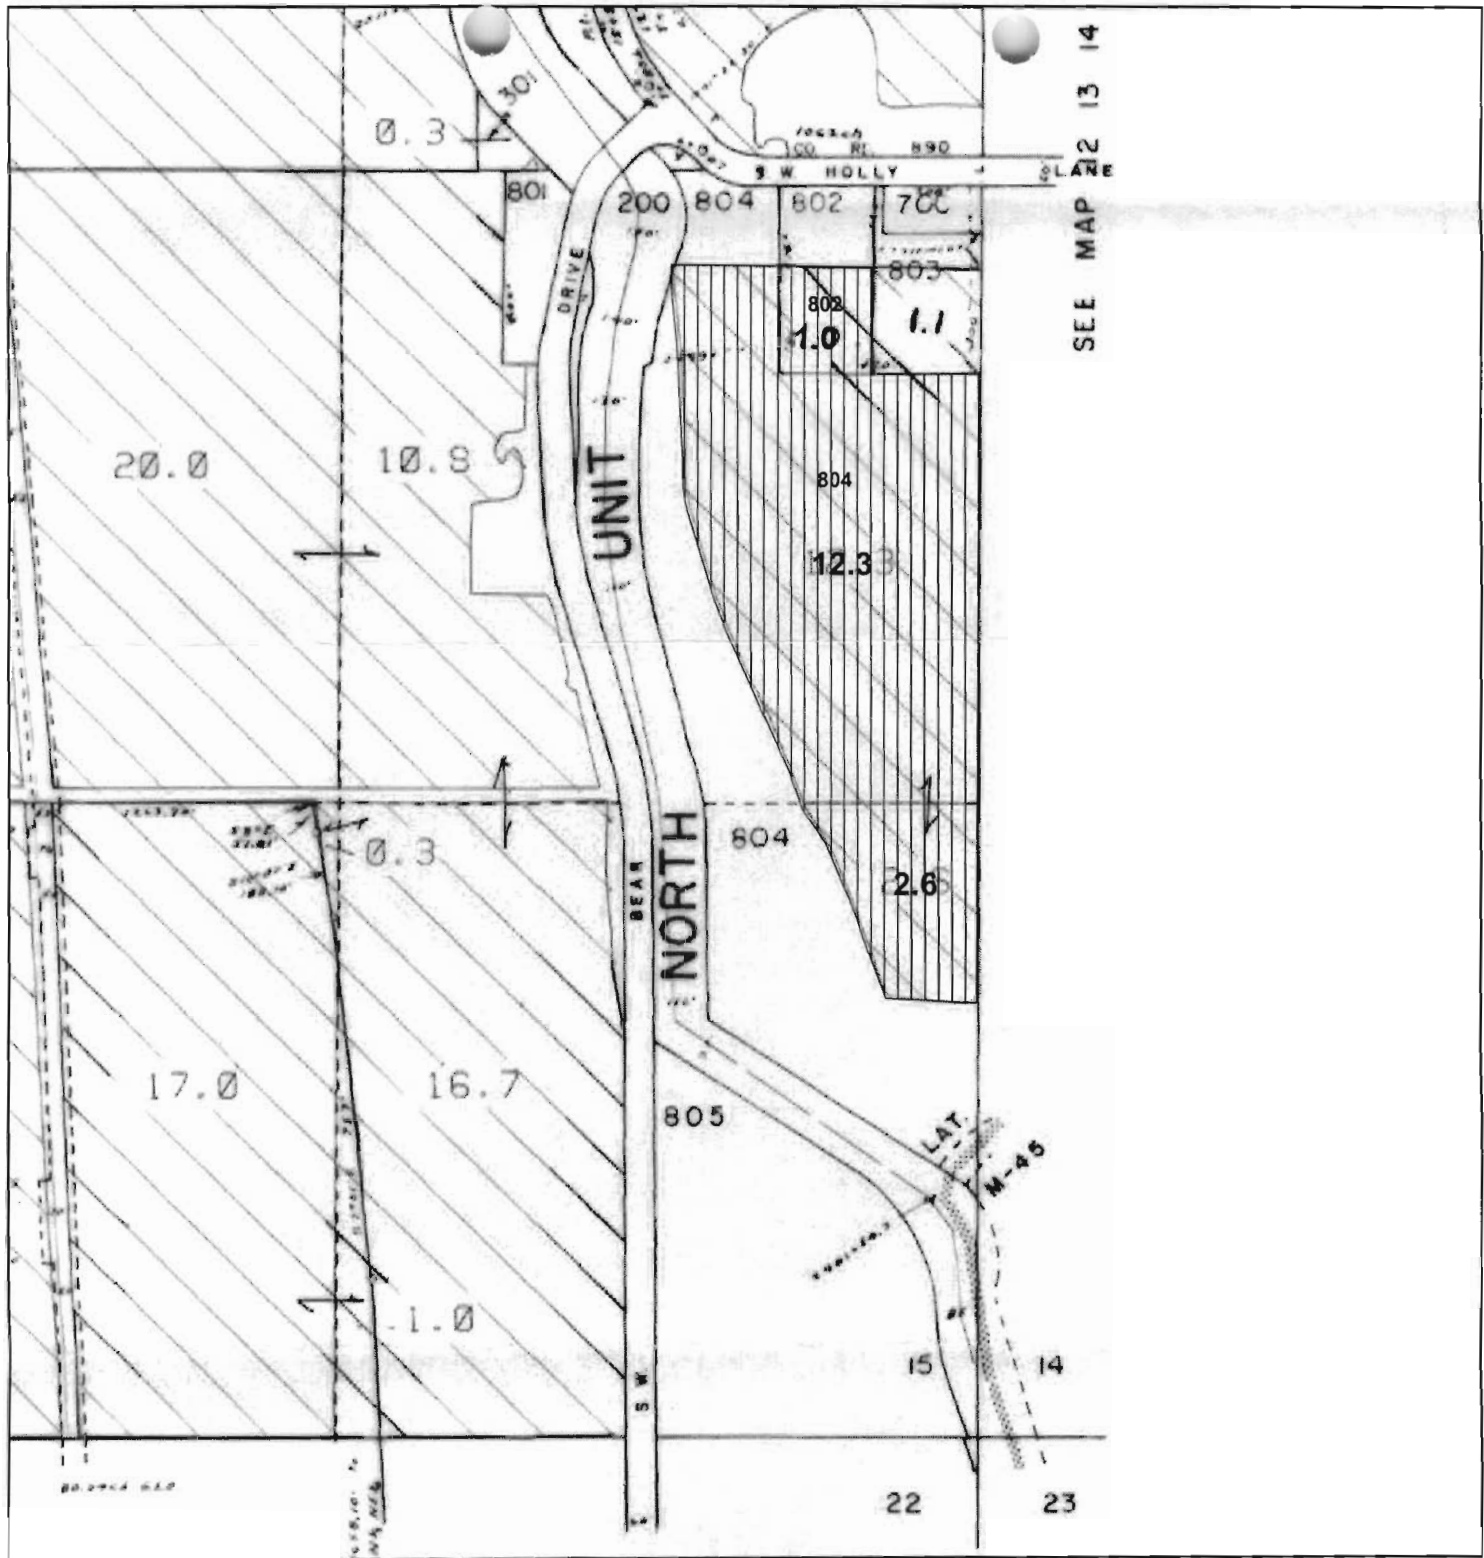

Scale 1" = 400'


**RECEIVED**  
 APR 19 2005  
 WATER RESOURCES DEPT  
 SALEM, OREGON

North Unit Irrigation District  
 2024 NW Beech Street  
 Madras OR 97741  
 Phone: (541)475-3625  
 Fax: (541)475-3905  
 email: nuid@palmain.com



Steinbeck, Shaun D. & Michelle L.  
 Section 15, Township 12S, Range 13E WM  
 NESE Tax Lot 804 & 802  
 SESE Tax Lot 804

INSTREAM - DESCHUTES

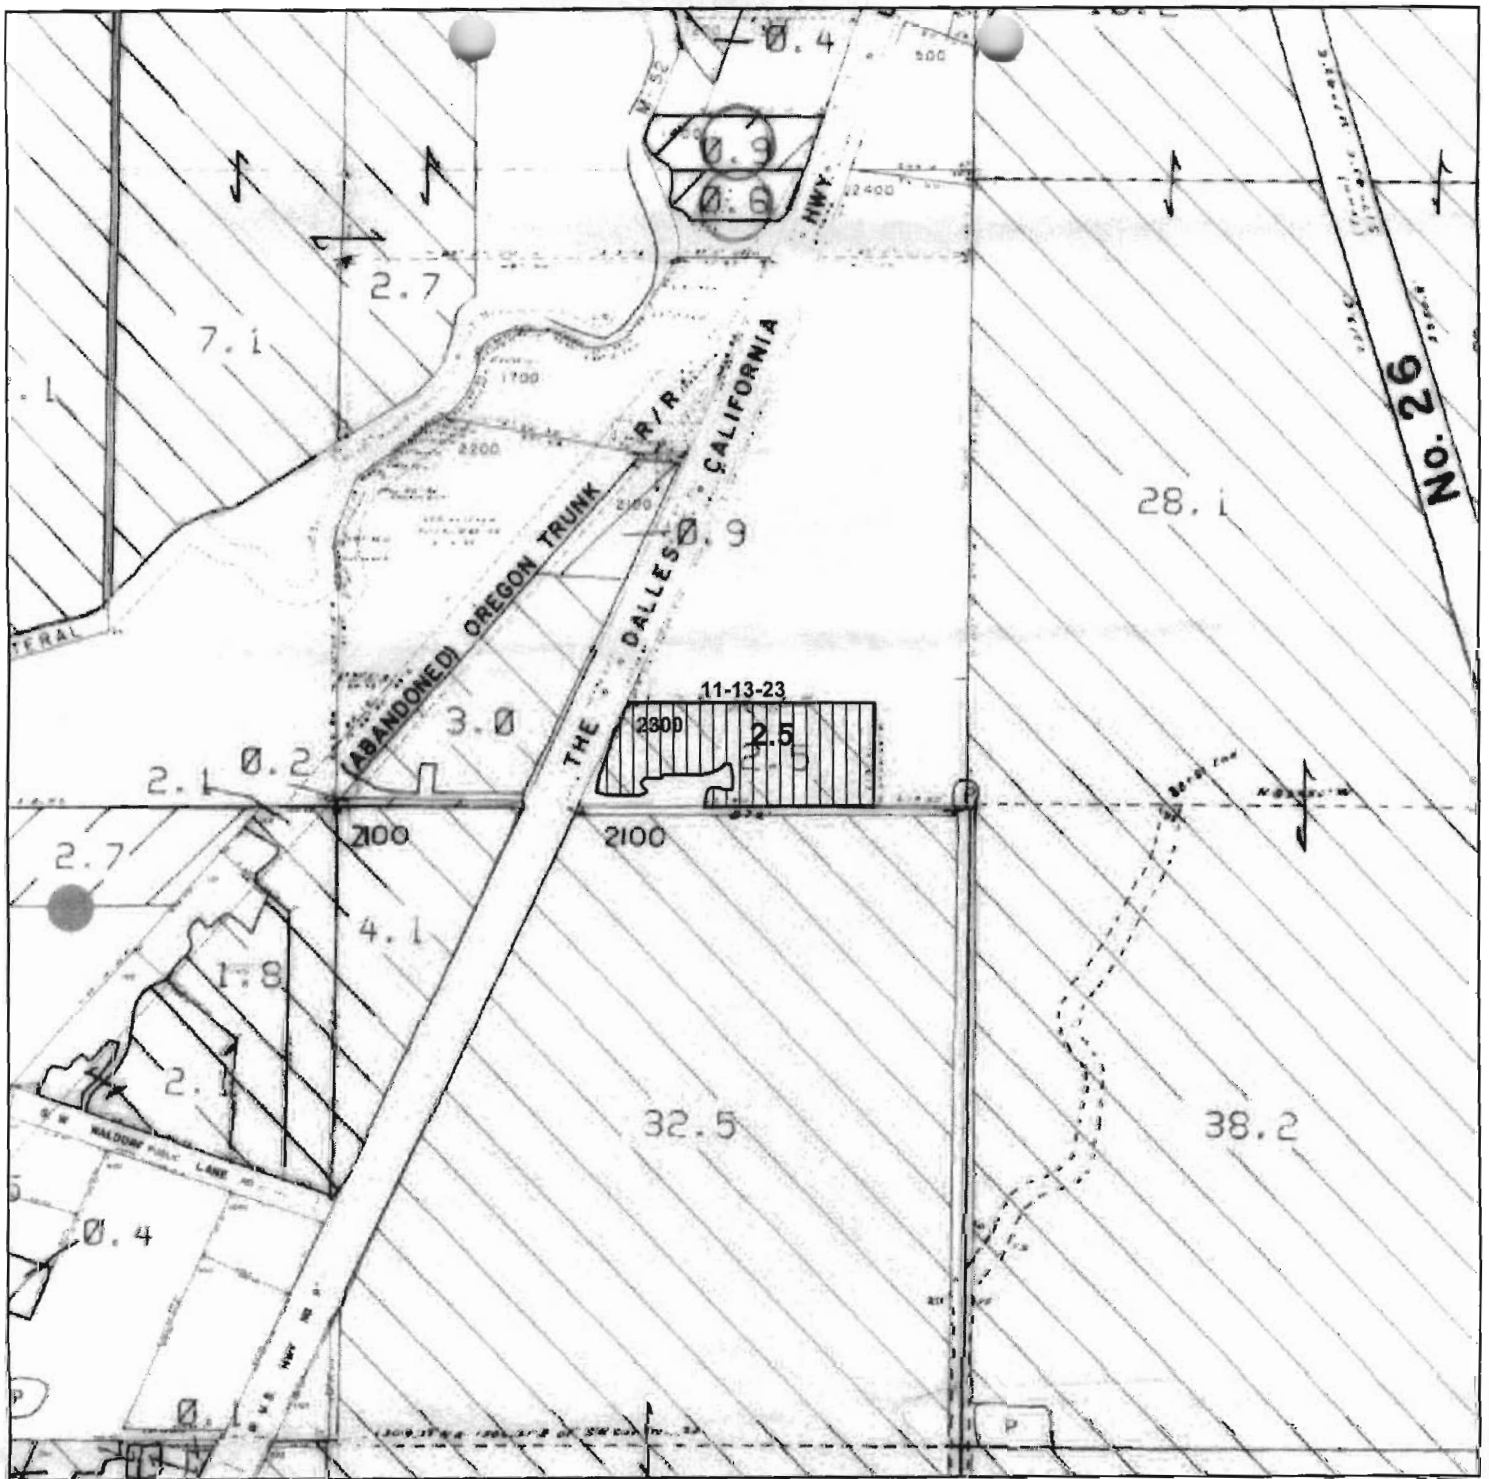

Scale 1" = 400'


**RECEIVED**  
 APR 19 2005  
 WATER RESOURCES DEPT  
 SALEM, OREGON

North Unit Irrigation District  
 2024 NW Beech Street  
 Madras OR 97741  
 Phone: (541)475-3625  
 Fax: (541)4753905  
 email: nuid@palmain.com



Janet Mendez & Erik Cook  
 Section 23, Township 11S, Range 13E  
 SENW Tax Lot 2300

 **INSTREAM - DESCHUTES**

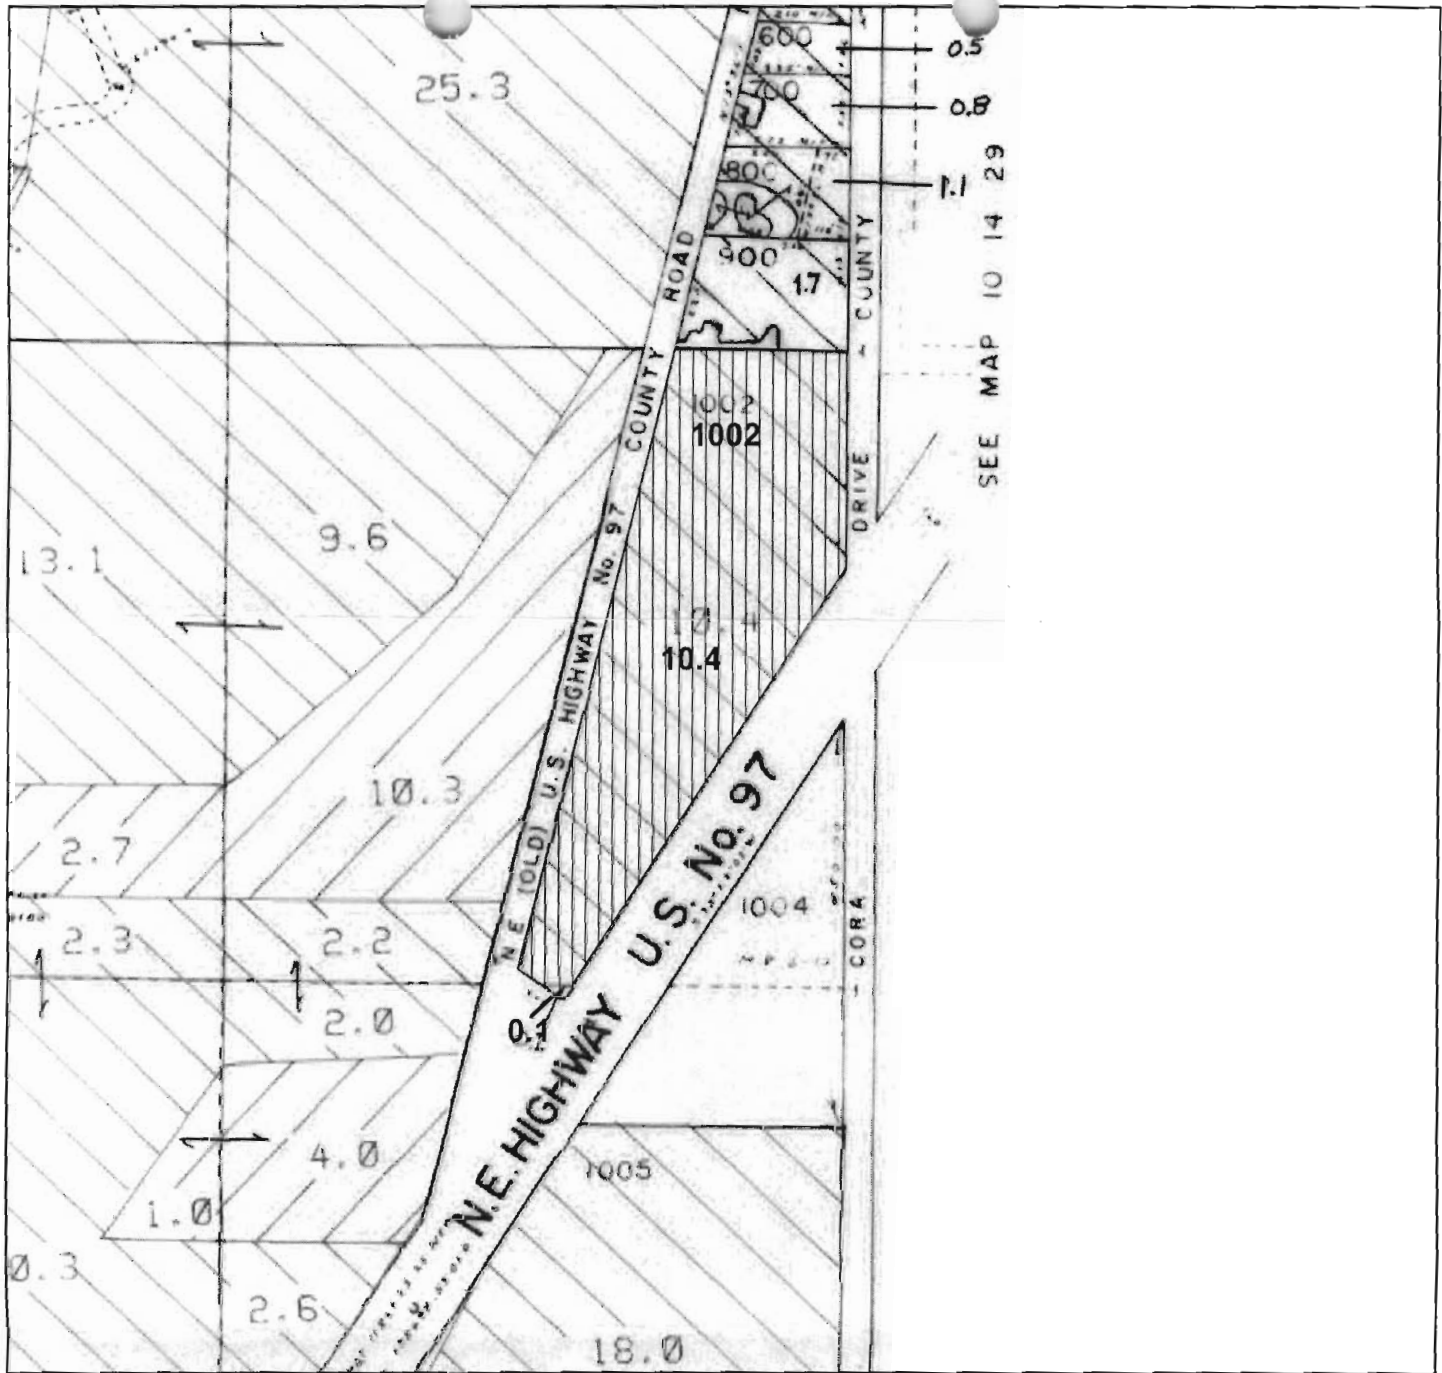

Scale 1" = 400'

**RECEIVED**  
 APR 19 2005  
 WATER RESOURCES DEPT  
 SALEM, OREGON

North Unit Irrigation District  
 2024 NW Beech Street  
 Madras OR 97741  
 Phone: (541)475-3625  
 Fax: (541)475-3905  
 email: nuid@palmain.com



V. Jeanne Dodson-Bergen  
 Section 30, Township 10S, Range 14E WM  
 NESE & SESE Tax Lot 1002

 INSTREAM - DESCHUTES