

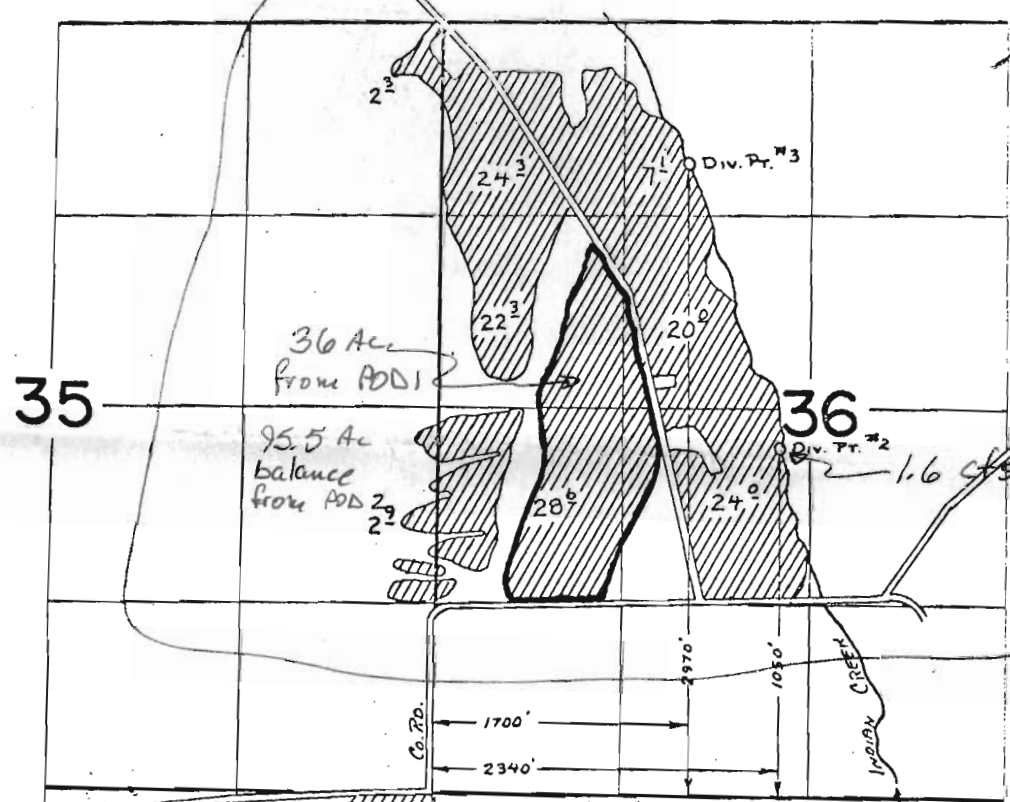


# T.1N8.S.,R.39E.,W.M.

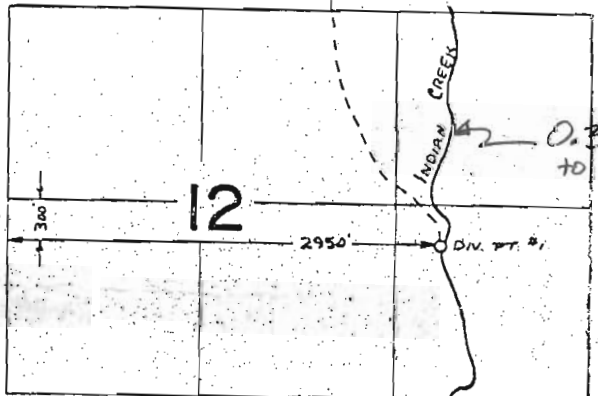

*not receiving water*

# T.1S.,R.39E.,W.M.

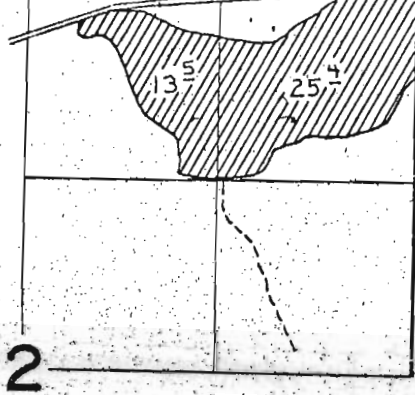

## FINAL PROOF SURVEY UNDER

**RECEIVED**  
MAY 23 2005  
WATER RESOURCES DEPT  
SALEM, OREGON

Application No. 42173... Permit No. 32155...  
IN NAME OF

RUSSELL & PATRICIA BINGAMAN.

Surveyed SEPT. 13 1974, by L.H. NUNN...