

Township 9 South Range 5 West

14

13

0.6 per certificate

0.79

28.09

22676

Taxlot 102

18.09

23

24

0.29


16.81

26647

RECEIVED

JUN 07 2005

WATER RESOURCES DEPT
SALEM, OREGON

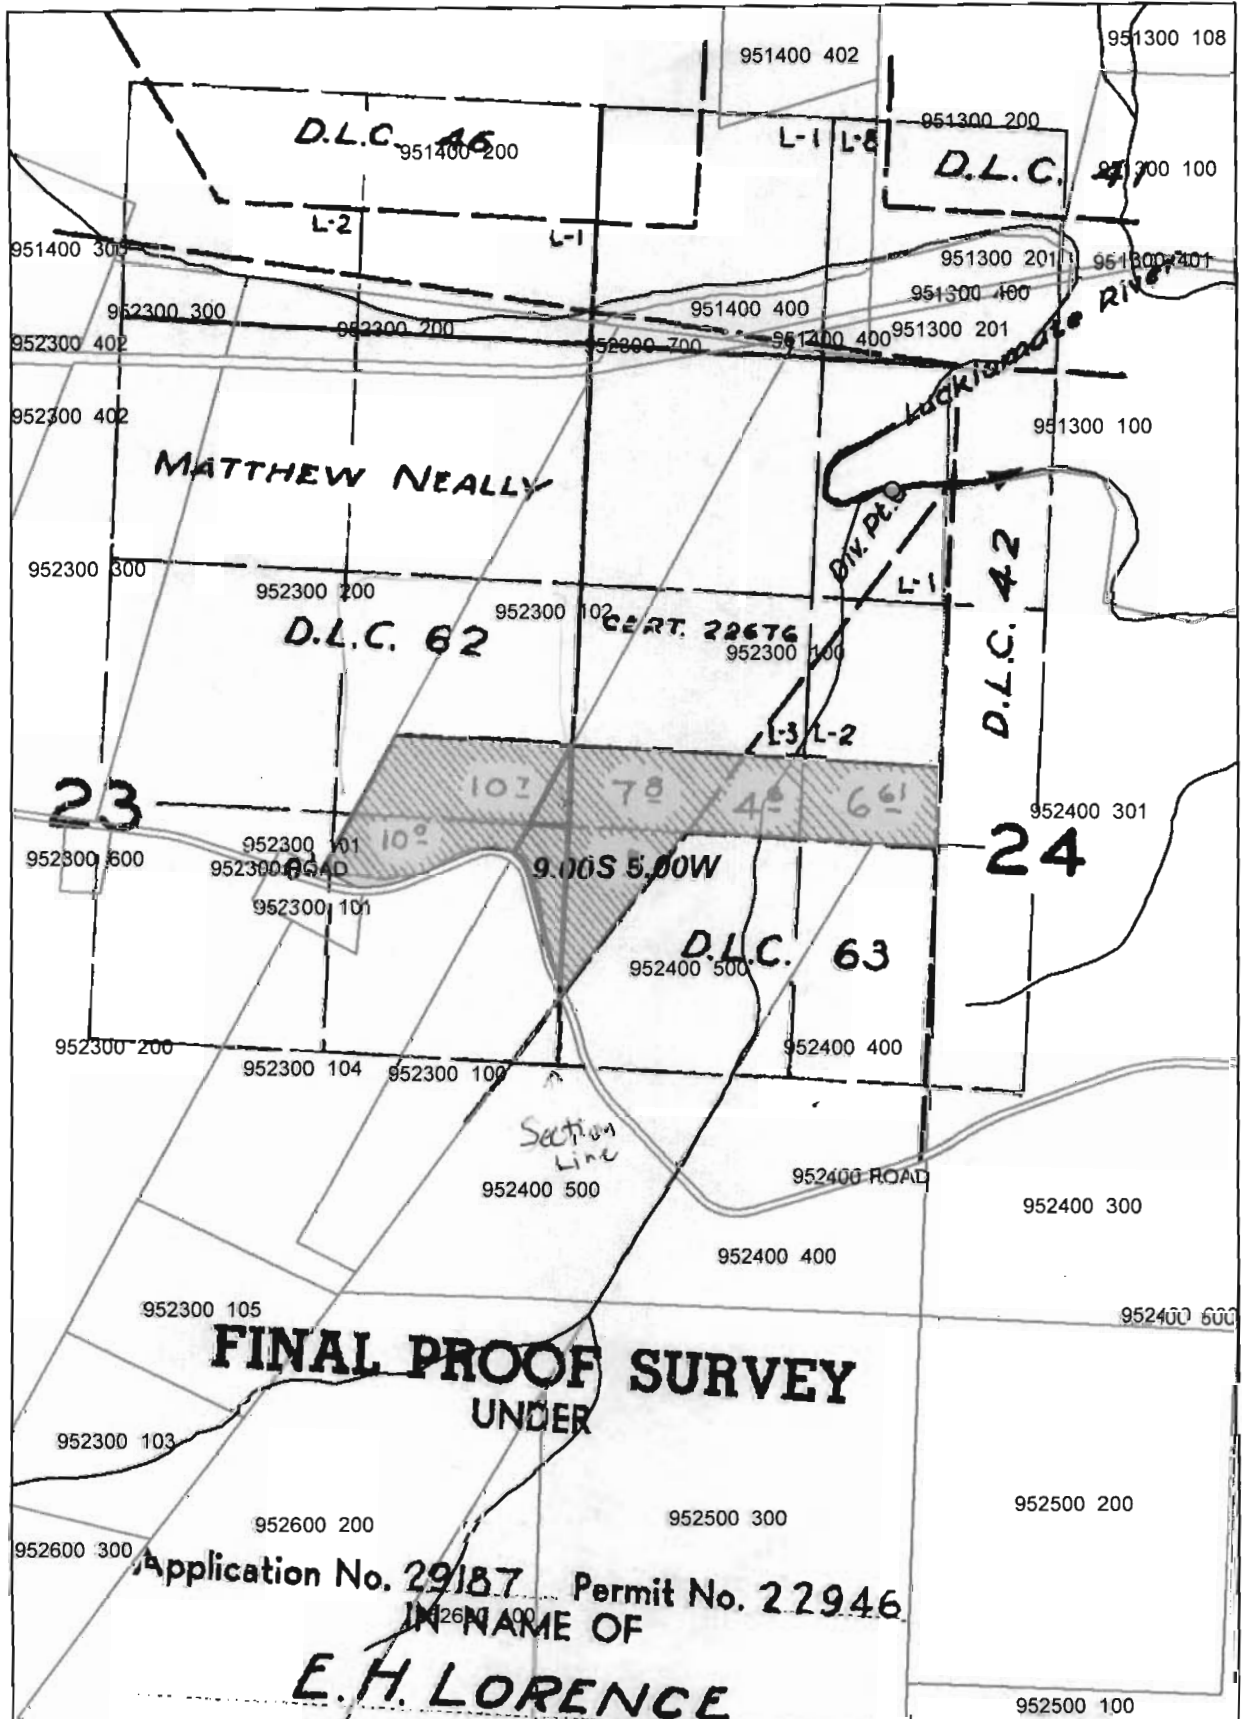

Line 1111 4.28 out of 23

L 664 takes 3.99 out see 23 & 24 out of 24



LI

951400 200

951300 201

951400 400

951300 400

951400 500

951300 201

951400 700

V.I.S.

NEALLY

952300 200

5°

31°

951300 100

952300 102

9.00S 5.00W


62

952300 100

25°

33°

20°

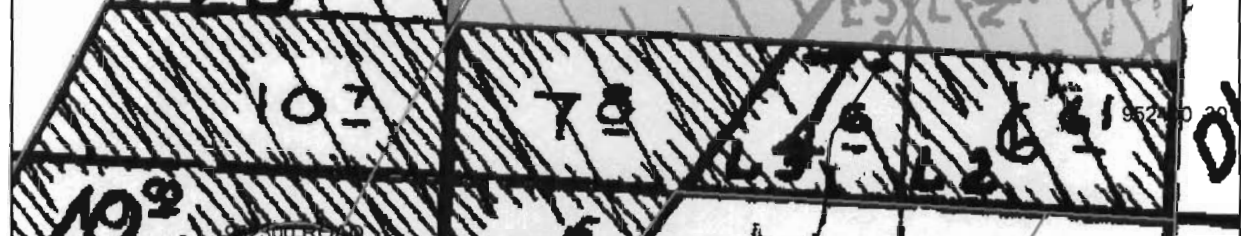

952300 101

952300 101


952300 104

952300 100


92100 ROAD
95240 500

D.L.C.
63

63

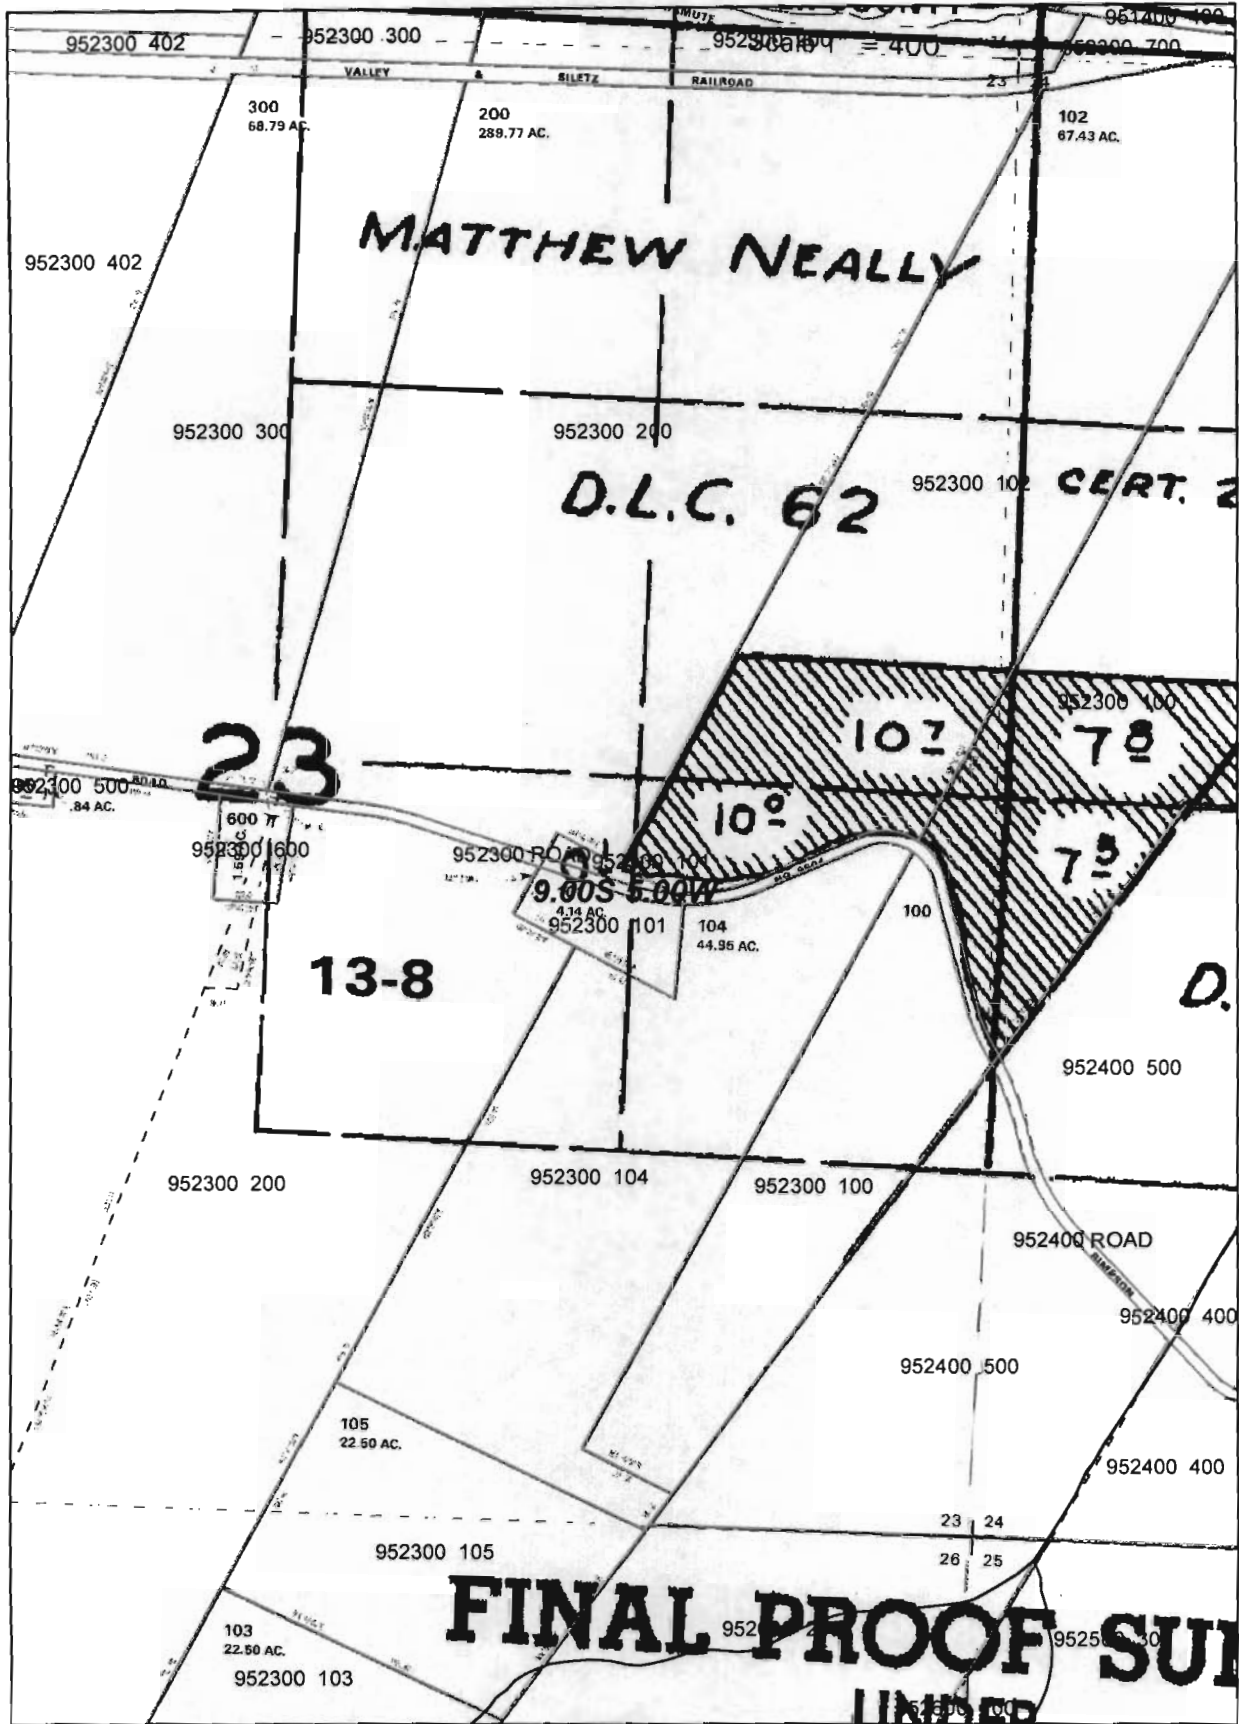

pink = oregon GIS
 tax lot
 Black = F.P. Map
 Yellow = Arc Map tax lot layer

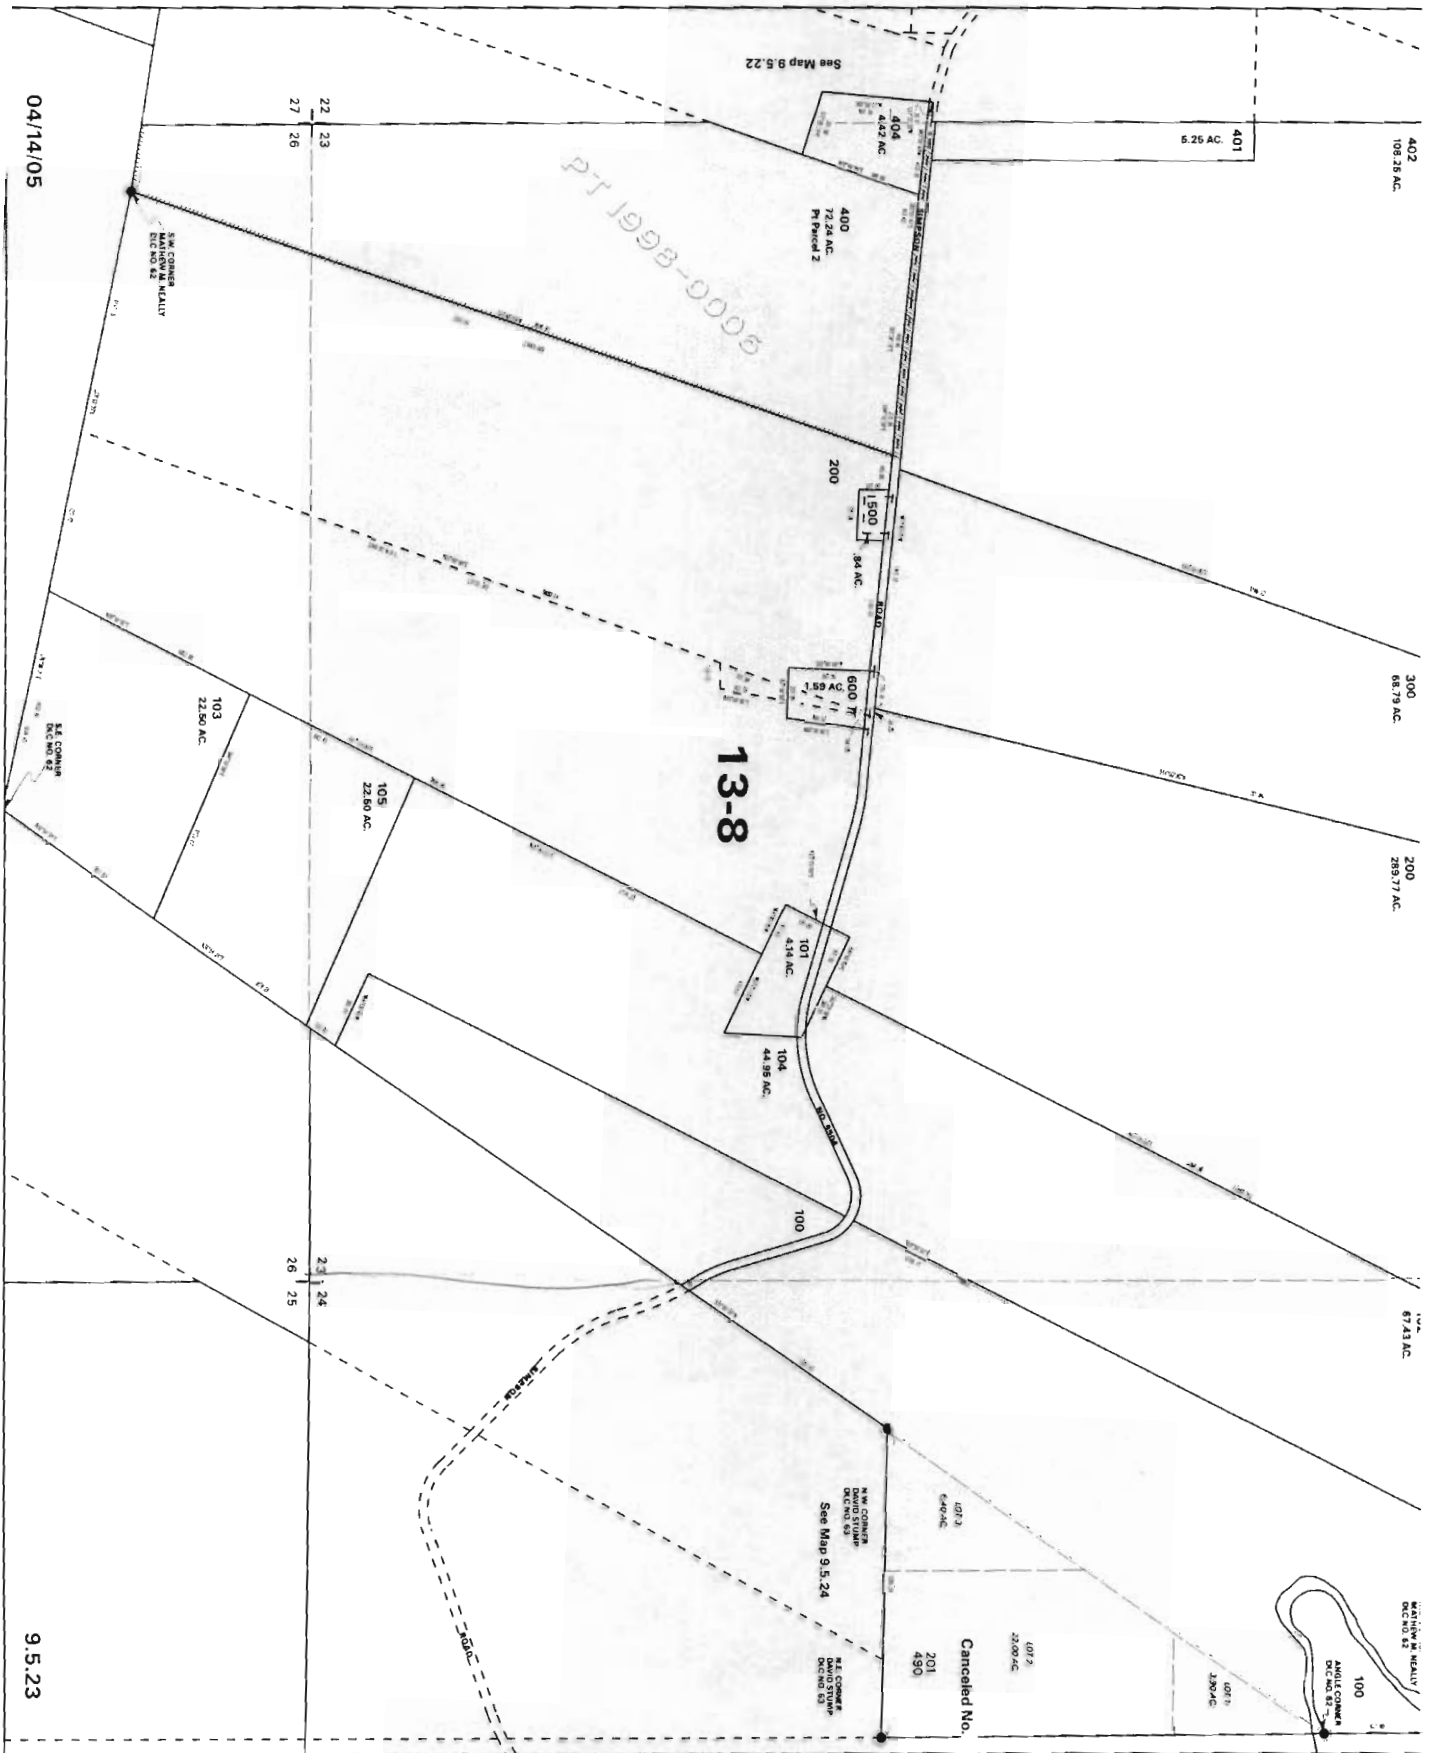

04/14/05

9.5.23

13-8

PT 1998-0005

Canceled No.
























22 23
27 26

23 24
26 25





