T. 28 S., R. 7 W.

Scale: 1" = 1000'

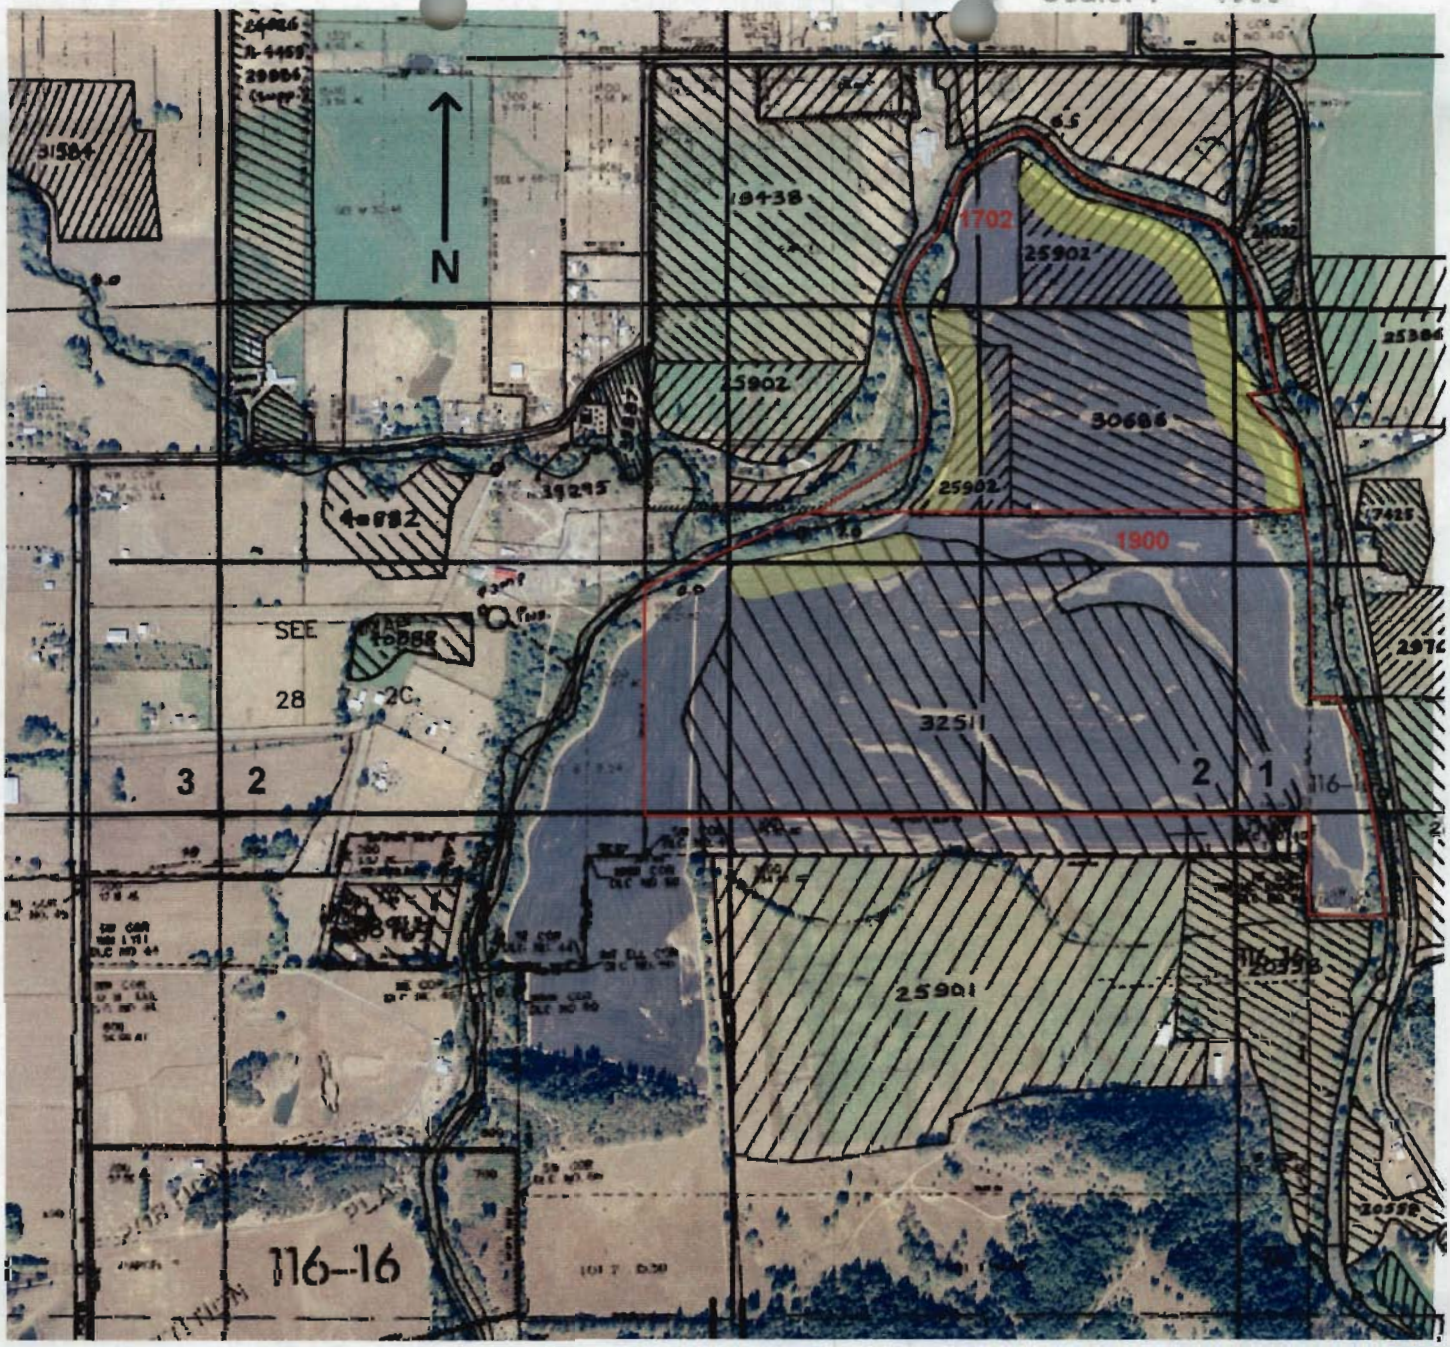

Permit

= 25902 - 3.7 ac. NWSE, 0.46 ac. NESE, 5.07 ac. SENE of Sec. 2
(C-57718)

30686 - 2.74 ac. NWSW of Sec. 1; 0.8 ac. NWSE, 1.97 ac. NESE, 0.12 ac. SWNE of Sec. 2
(C-37907)

0.2

32511 - 2.07 ac. SWSE, 2.07 ac. NWSE of Sec. 2
(C-38091)

19.08

RECEIVED
JAN 27 2004
WATER RESOURCES DEPT
SALEM, OREGON