


10

TOWNSHIP 33 S, RANGE 2 E, W. M.

North

West

East

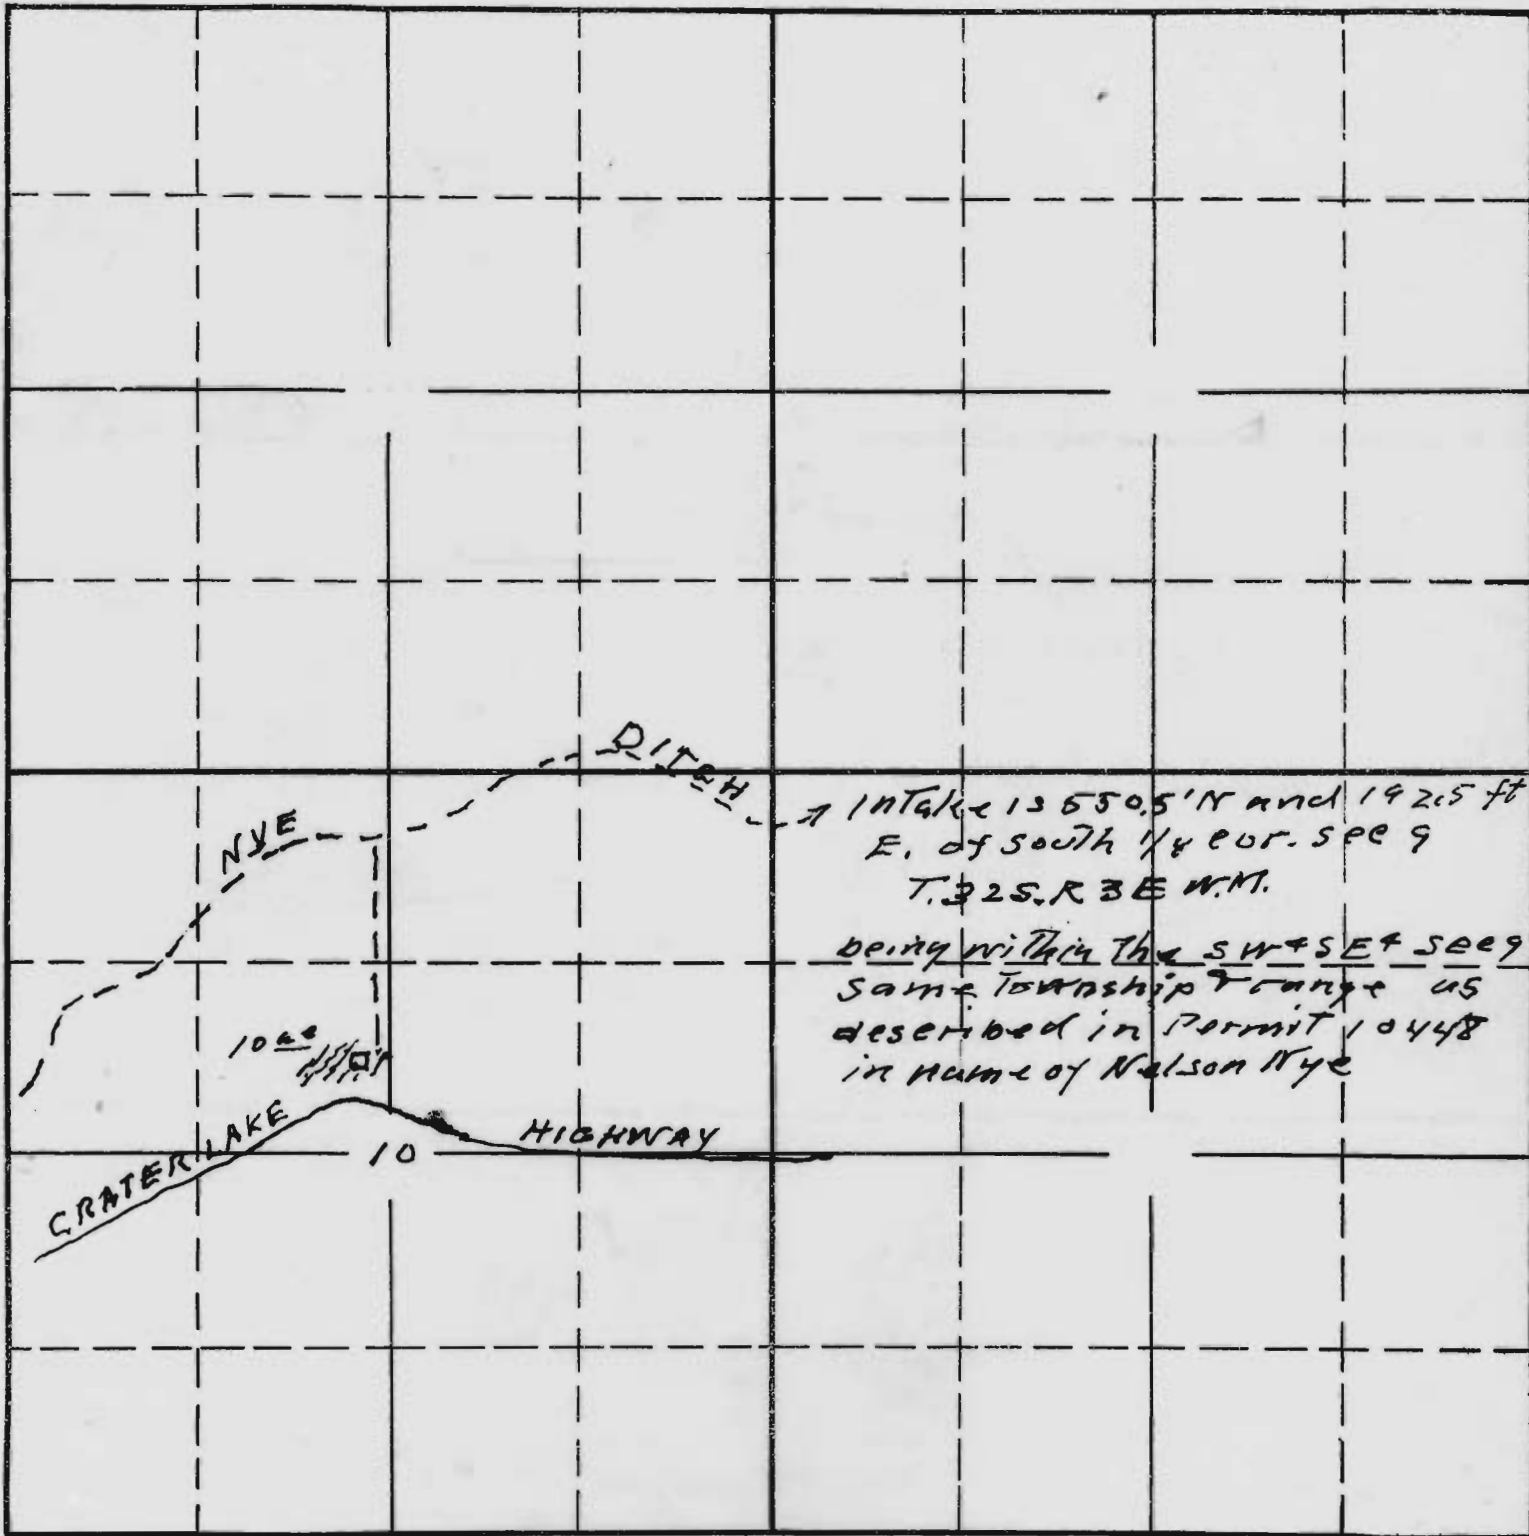

South

Map To accompany application of
 Geo L Santzer Lumber Co for change
 in use of part of the water described
 in Permit No 14509

APPLICATION No.

PERMIT No.

J-8

This office 7/25/44