


T.5 S.R.II E.W.M.

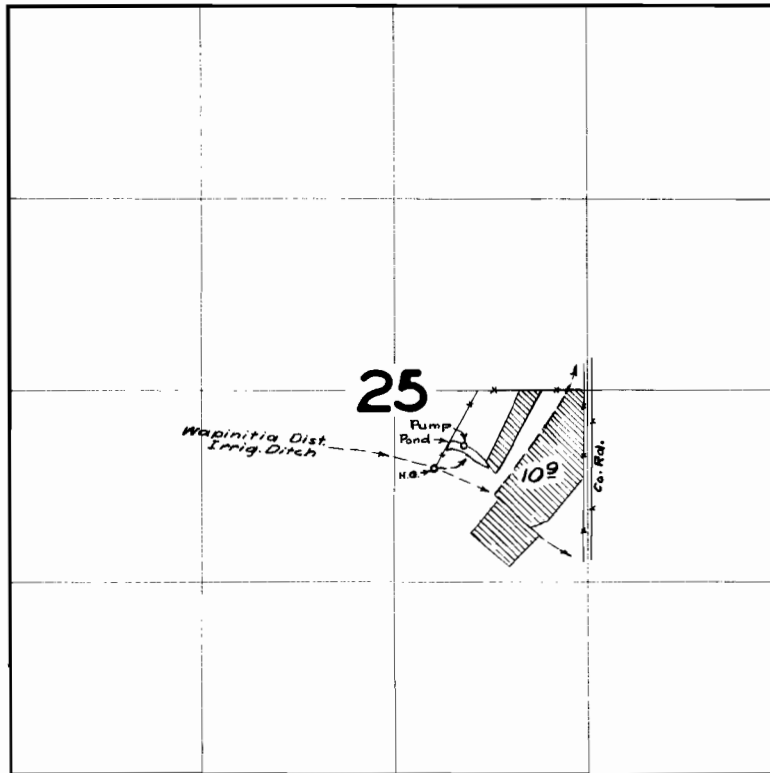

FINAL PROOF SURVEY UNDER

Transfer No. J-29

Application No. Permit No.
IN NAME OF

..... JOHN or JULIA JOYCE

Surveyed 12 NOV. 1959, by M. Bish