


4

T. 36 S., R. 1 W., W.M.

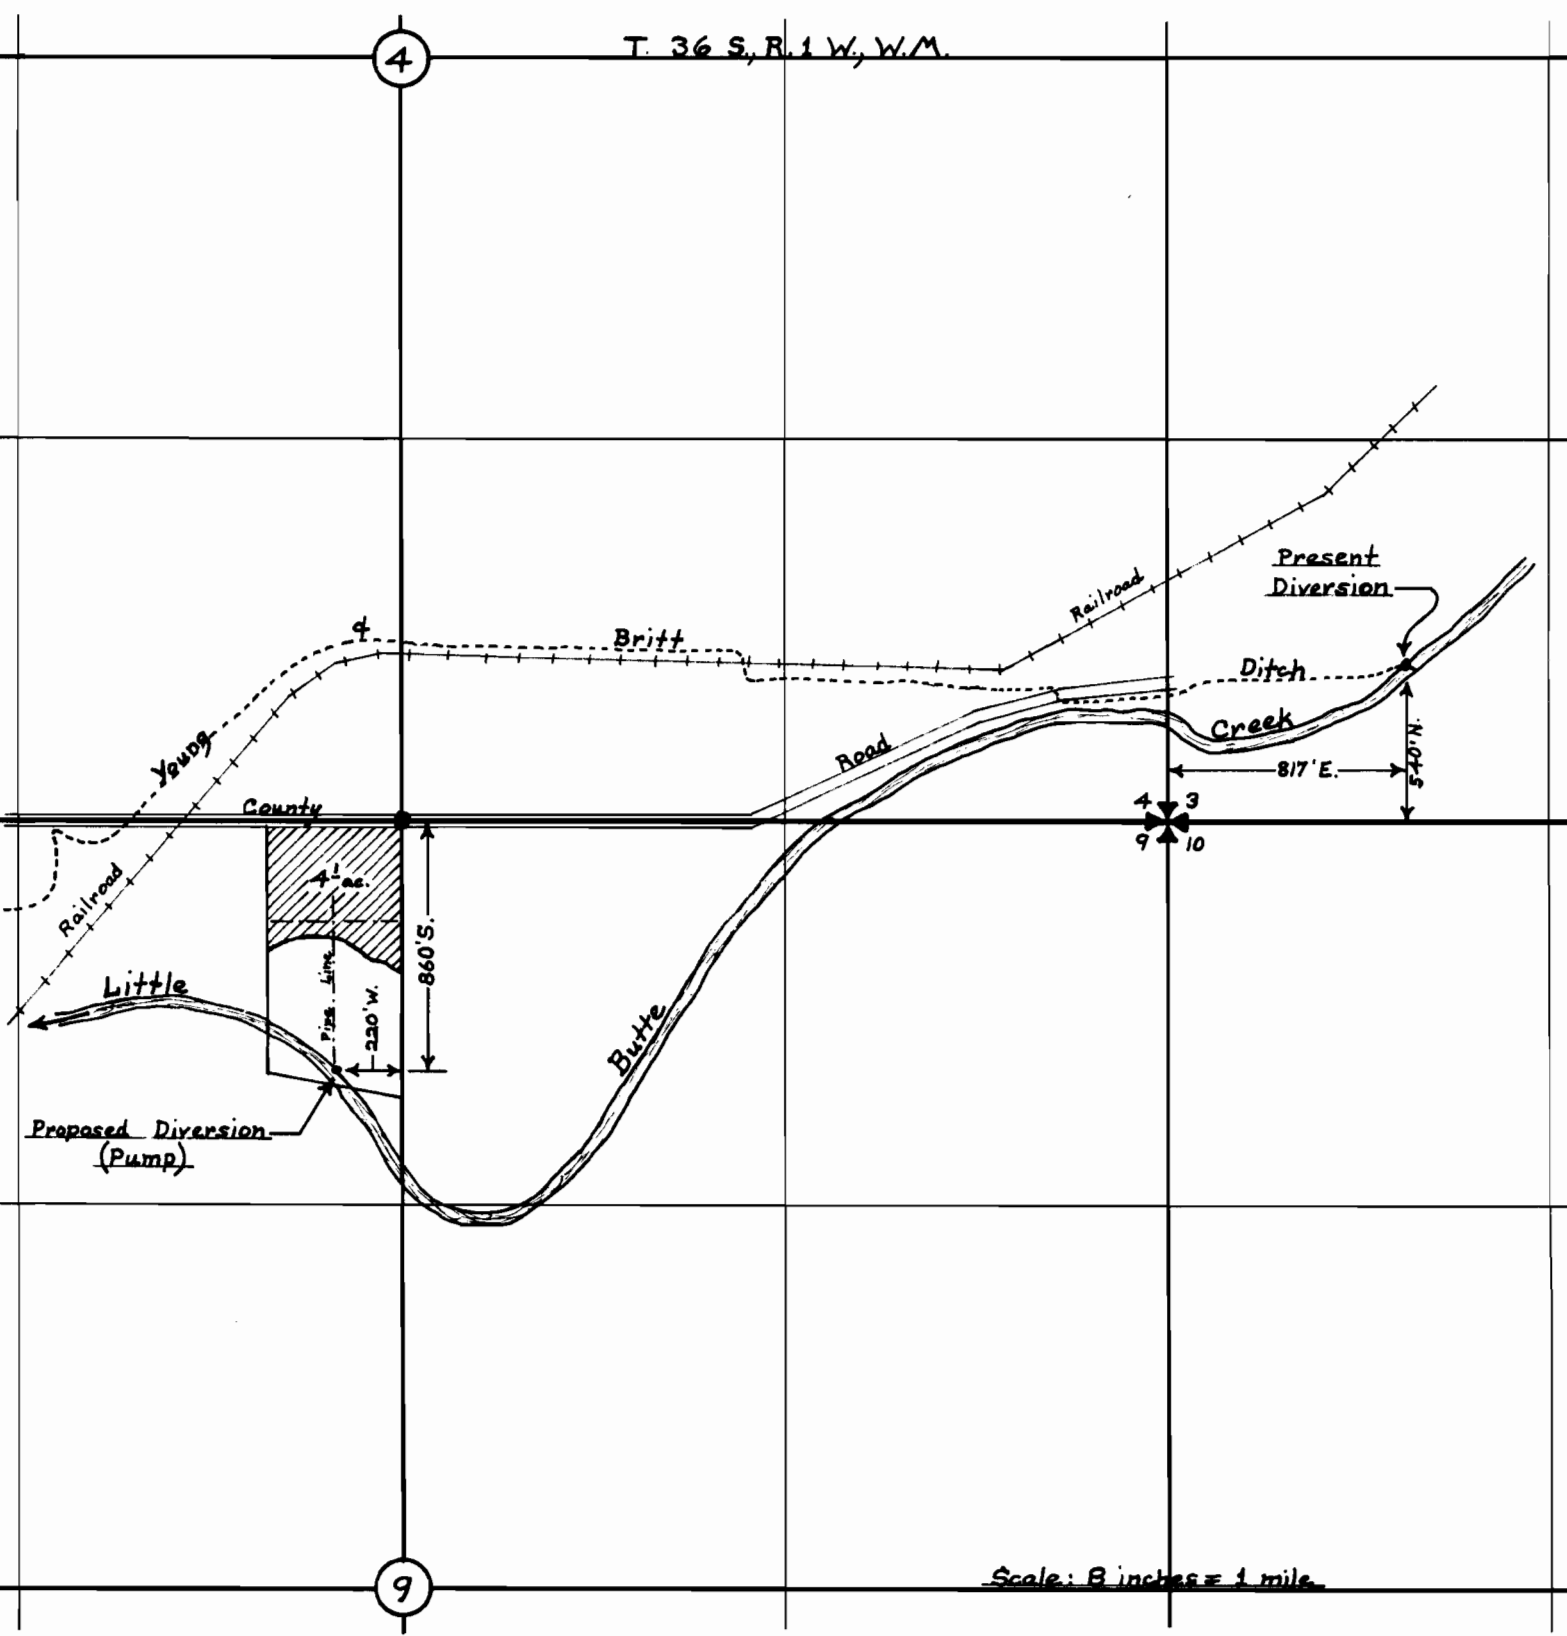

Scale: 8 inches = 1 mile

Map to accompany application in the name of Nellie R. Jackson, for a change in point of diversion of water from Little Butte Creek.

August 6, 1959

David C. Hendrix, Watermaster Dist. #15